


T. 28 S., R. 7 W., W.M.

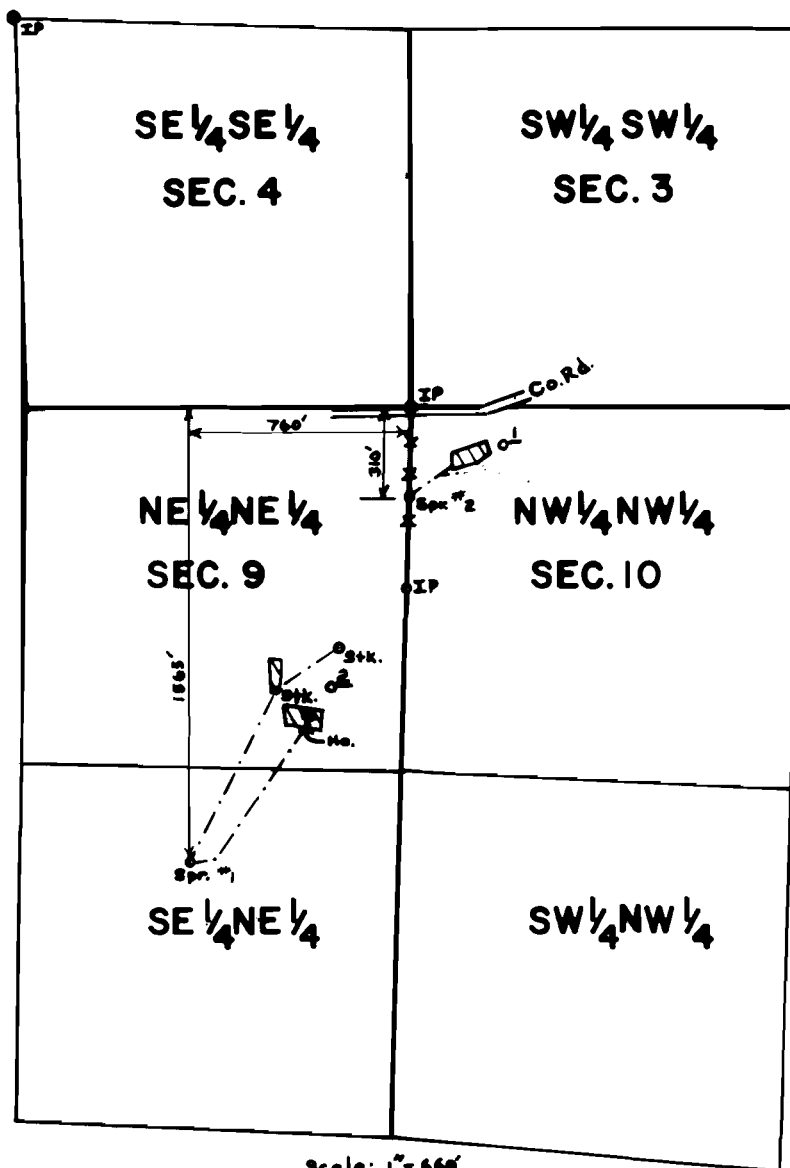

Scale: 1" = 660'

FINAL PROOF SURVEY
UNDER

Application No. 53501 Permit No. 40318
IN NAME OF

JACK L. JANSEN

Surveyed NOV. 8, 1977, by D.W. SPARKS.