


T.23S. R.7W. W.M.

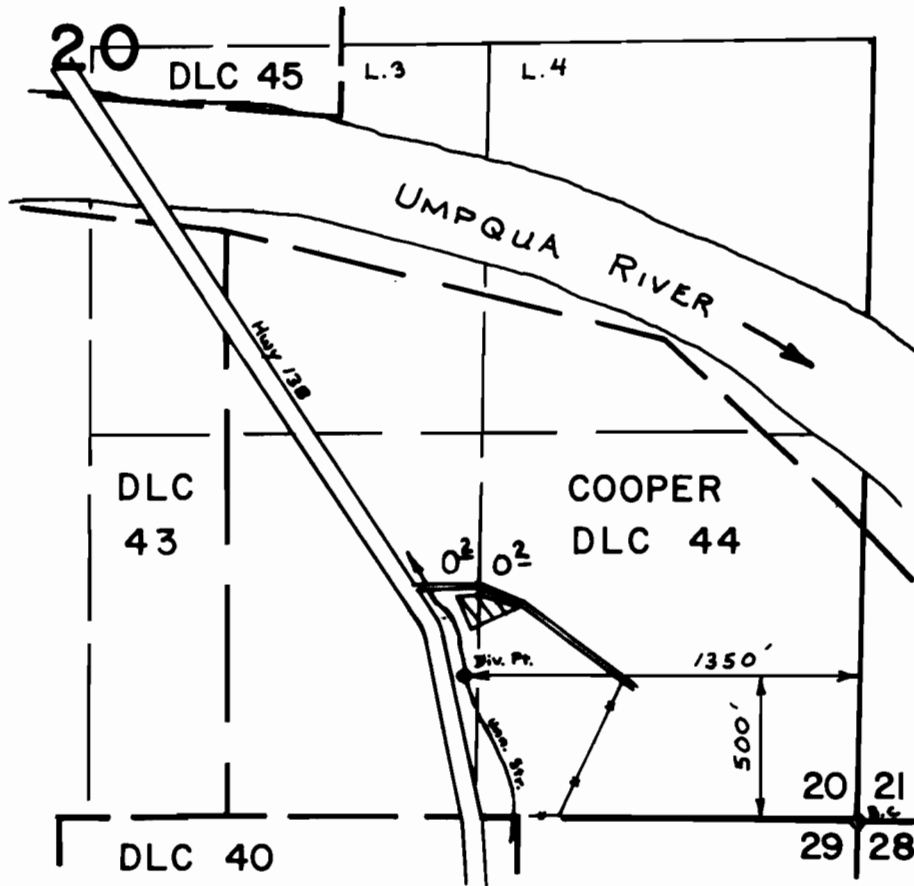

SCALE : 1" = 660'

FINAL PROOF SURVEY
UNDER

Application No. 53734 Permit No. 40353
IN NAME OF

FRANK & JANICE GILL

Surveyed April 12, 1978, by D. Sparks