


T.27S. R.7W. W.M.

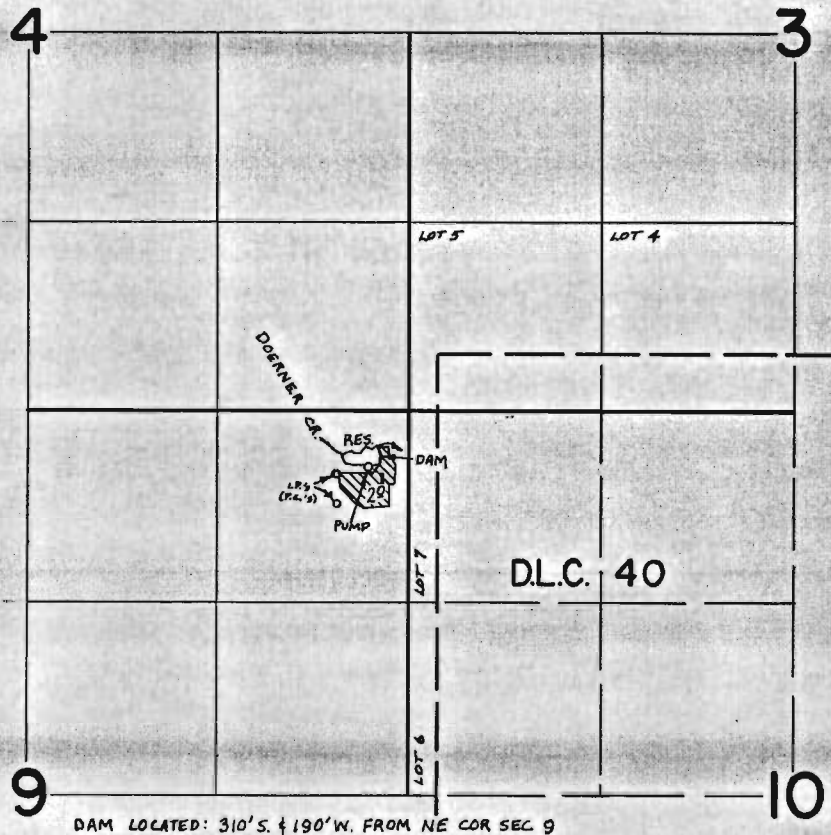

**FINAL PROOF SURVEY**  
UNDER

R-47404                      R-5712  
Application No. 47405    Permit No. 35529  
IN NAME OF

*Jack Edward Hunter*

Surveyed MARCH 25 1975, by L. TOLL