


T.27S. R.7W. W.M.

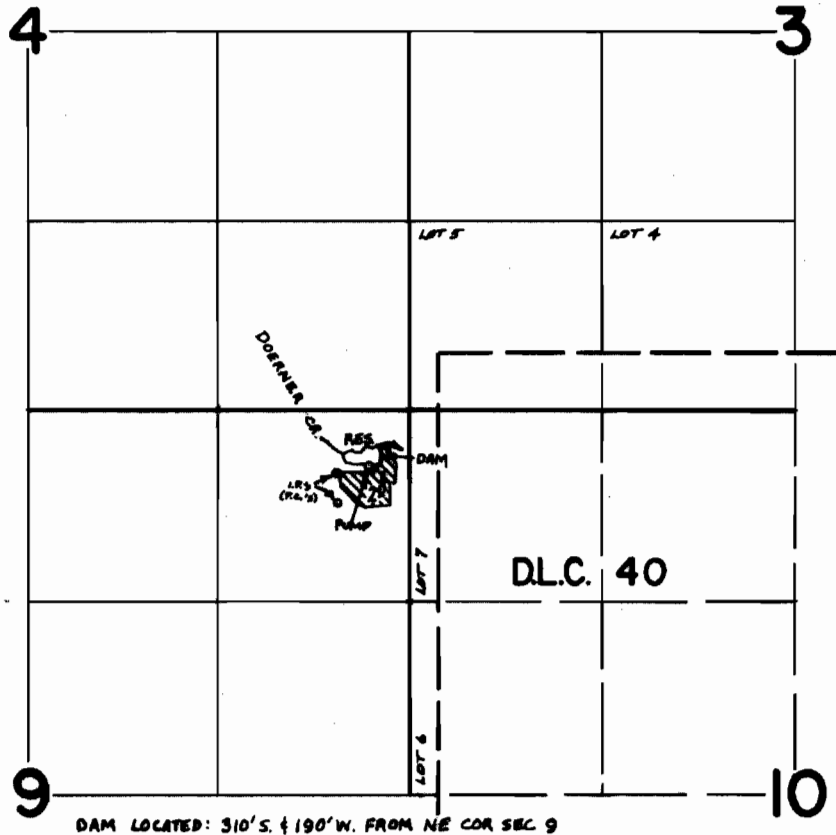

FINAL PROOF SURVEY
UNDER

R-47404 R-5712
Application No. 47405 Permit No. 35529
IN NAME OF

Jack Edward Hunter

Surveyed MARCH 25 1975, by L. TOLL