


T. 26 S., R. 5 W., W.M.

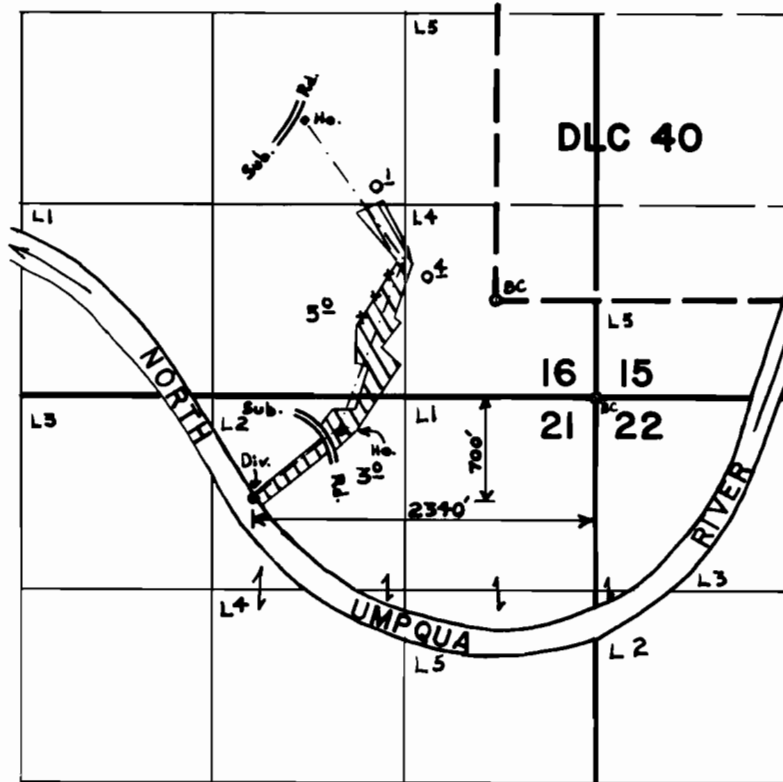

**FINAL PROOF SURVEY**  
UNDER

Application No. 49962... Permit No. 37584...  
IN NAME OF

**ROBERT S. & EDNA E. WILMETH**

Surveyed APR. 13... 1978, by D.W. SPARKS.....