


T. 25 S., R. 5 W., W. M.

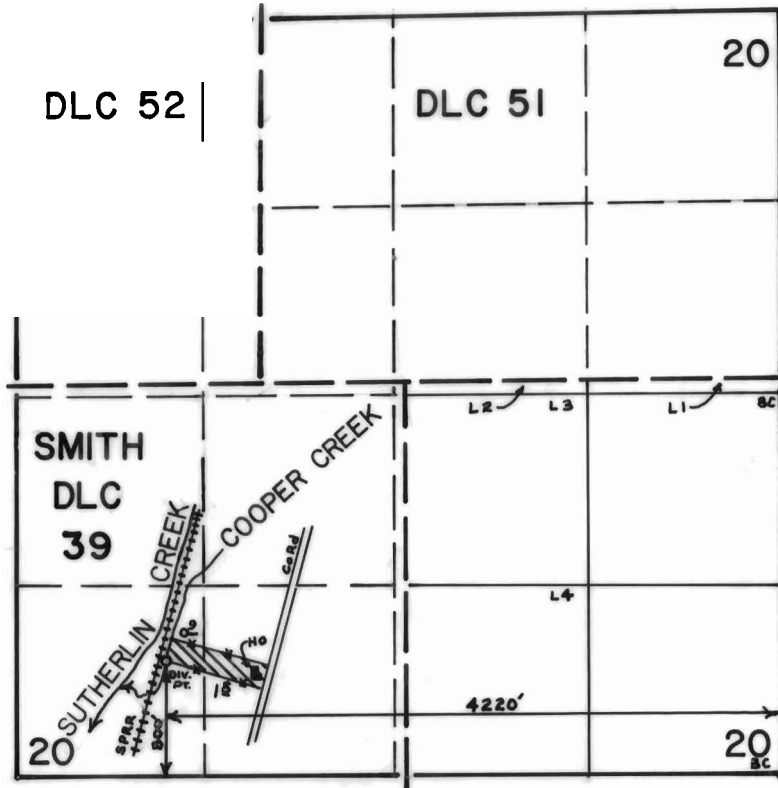

**FINAL PROOF SURVEY**  
UNDER

Application No. 52182 Permit No. 39293  
IN NAME OF

**WILLIAM J. & WANDA CRANFORD**

Surveyed OCT. 31, 1977, by D.W. SPARKS