


T.26½27S. R.6W. W.M.

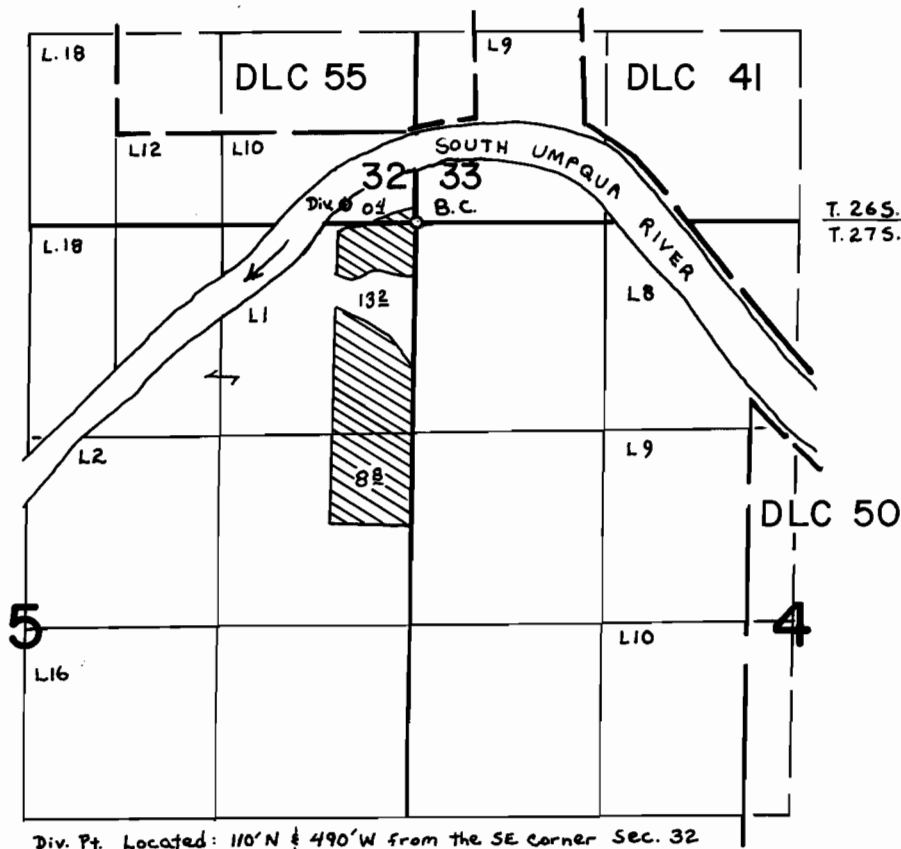

SCALE: 4" = 1mi.

**FINAL PROOF SURVEY**  
UNDER

Application No. 53069 Permit No. 38567  
IN NAME OF

STEPHAN BLAKE CONN

Surveyed Oct. 6, 1977, by D.W. Sparks.