


P-3736
C-49119

T.8S.R.27E.W.M.

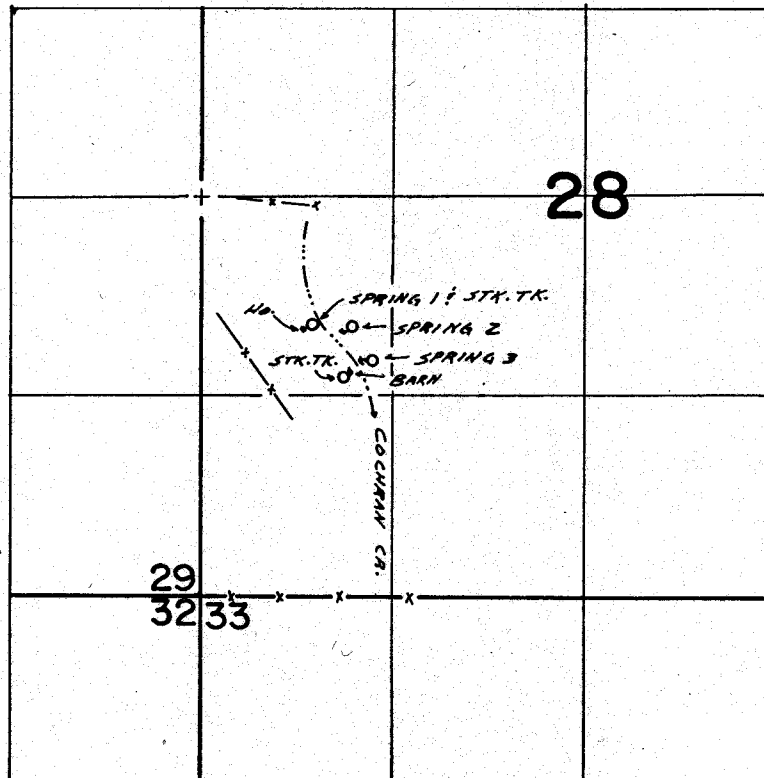

SPRING LOC. #1 - 870'S & 760'E }
#2 - 900'S & 1050'E } All From W 1/4 Cor. Sec. 28
#3 - 1120'S & 1180'E }

FINAL PROOF SURVEY
UNDER

Application No. 49522... Permit No. 37367...
IN NAME OF

.....ROBERT W. AURAND.....

Surveyed Oct. 18.... 1977., by S.C. BROWN.....