


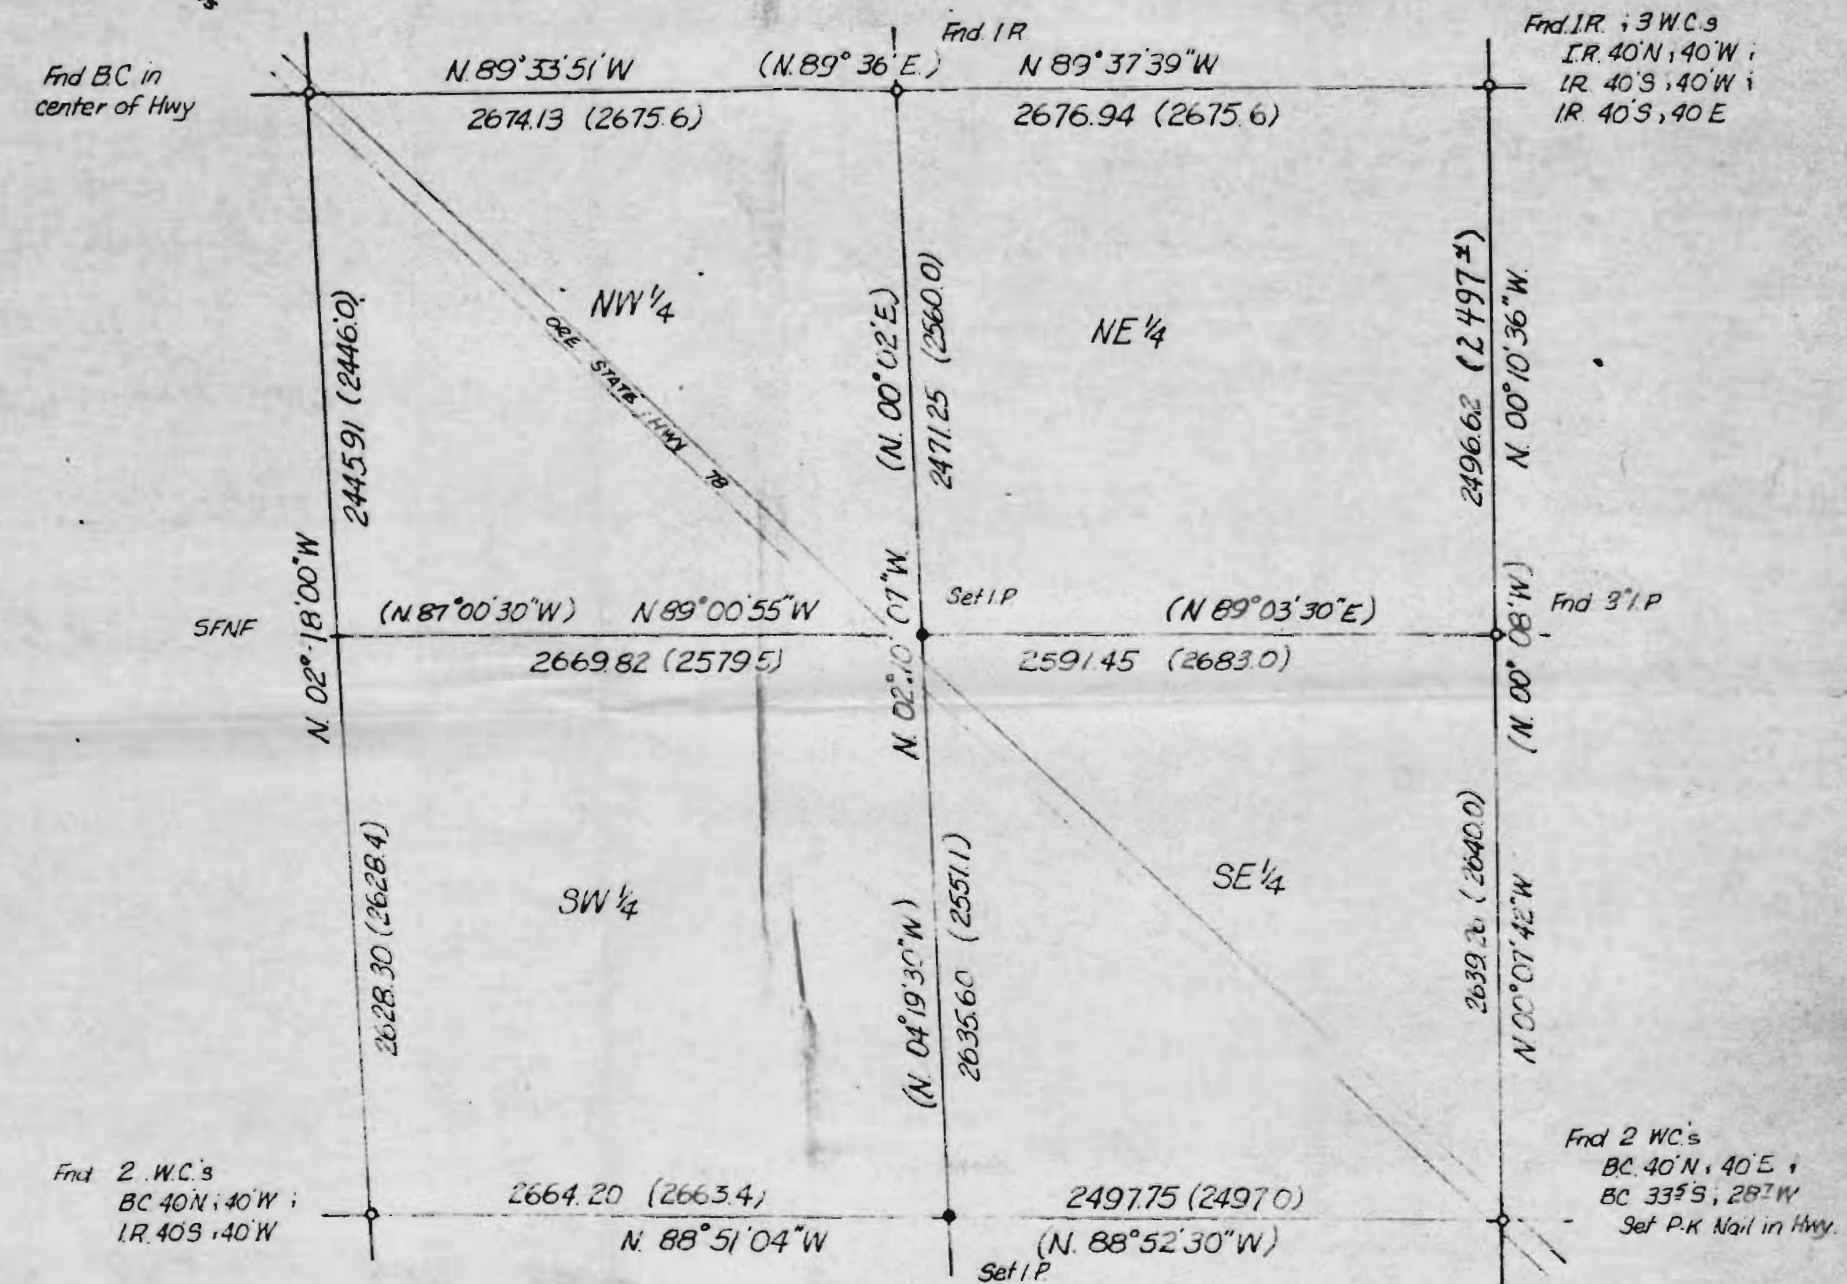

SURVEY MAP
of

Notes:

- Denotes Monuments found
 - Denotes I.P. set
- W.C. Witness Corner
B.C. Brass Cap

Basis of bearing is West line of Section 4 per M.V. Davenport March 1964 Survey Map. Distances and Bearings in parenthesis are those shown on Davenport Map.

for

J. Blackburn and. A. Gaines

Scale: 1" = 200'
(Print reduced)

SURVEY MAP
of the
SE ¼ of Section 4, T.24S, R.32E, WM.

May. 25, 1977



By: M.A. Palmer
254 N Alder
Burns, Oregon