


T. 35 S., R. 1 W., W.M.

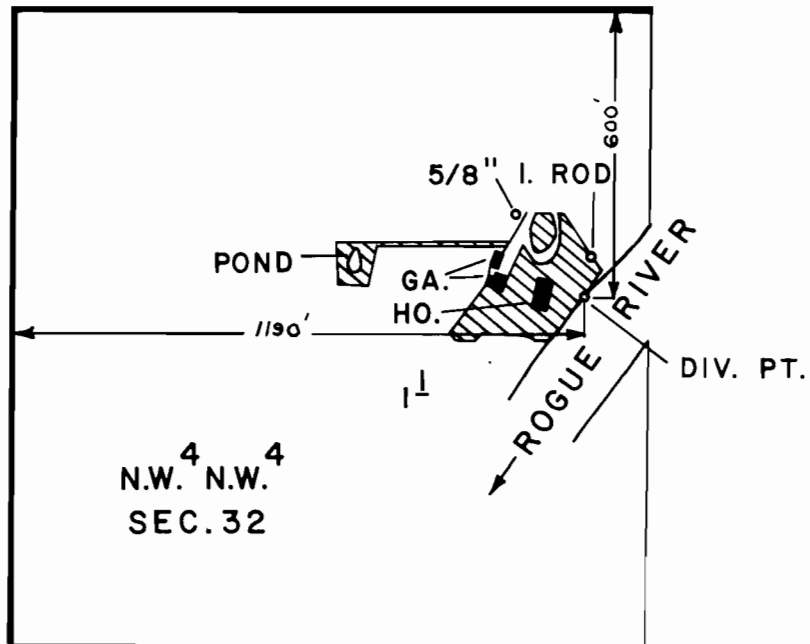

SCALE : 1" = 400 FT.

FINAL PROOF SURVEY
UNDER

Application No. 51995 Permit No. 39198
IN NAME OF

DAVID H. ELLIS

Surveyed MAY 15 1979, by B. SUND

D.H.M.
P.T.S. - 1979 - 14 - A