


T. 39 S., R. 3 W., W.M.

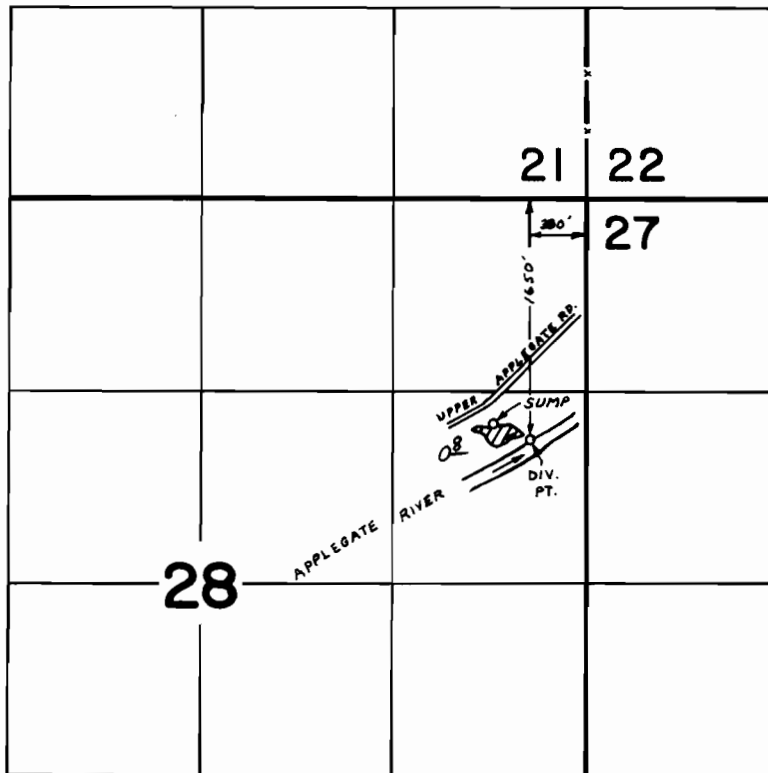

FINAL PROOF SURVEY
UNDER

Application No. 53894 Permit No. 40213 SUPPL.
IN NAME OF

GEORGE P. MAYO

Surveyed JUN. 7 78 by B. SUND
19.....