


T. 35 S., R. 1 W., W.M.

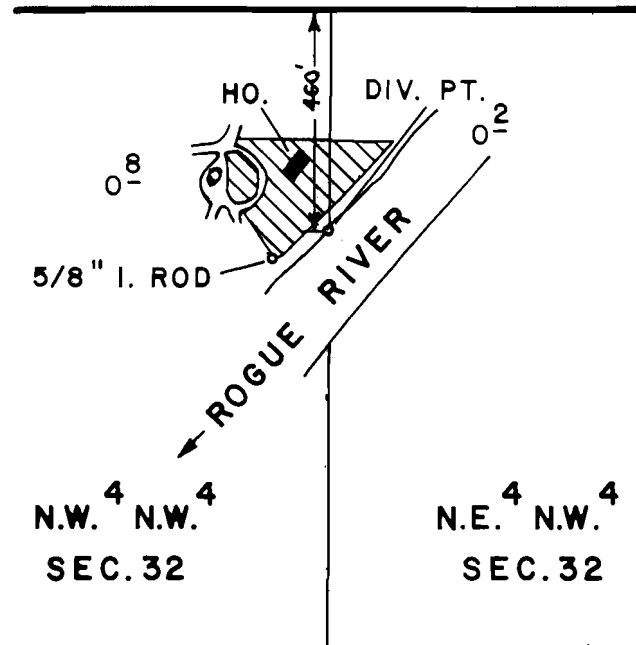

SCALE : 1" = 400 FT.

FINAL PROOF SURVEY
UNDER

Application No. 56291 Permit No. 42368
IN NAME OF

RALPH STEAN

Surveyed MAY 30 1979, by B. SUND

D.H.M.

P.T.S. - 1979-14-B