


T.33 S., R.6 W., W.M.

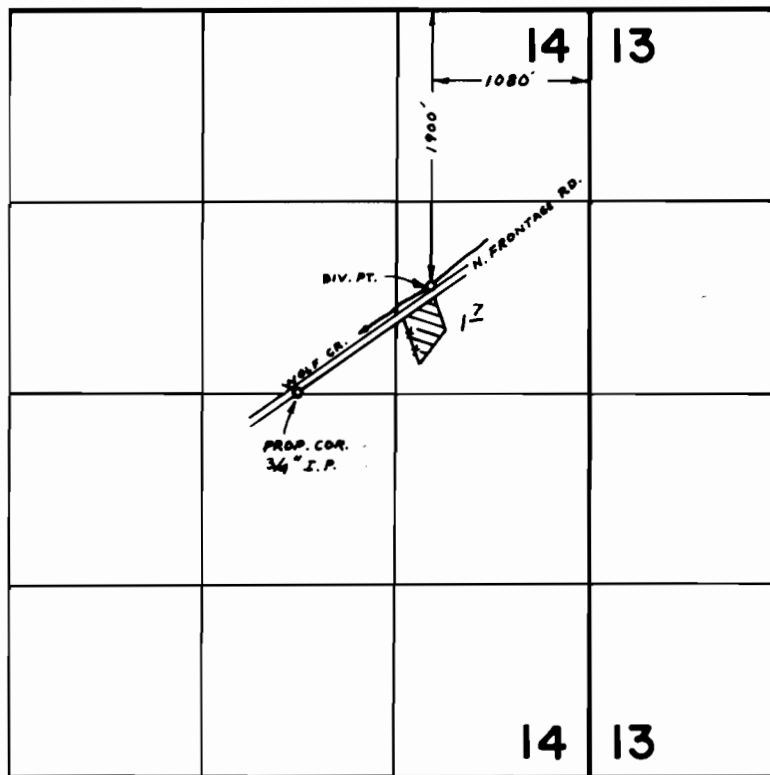

FINAL PROOF SURVEY
UNDER

Application No. 49058 Permit No. 36806
IN NAME OF

HENRY C. DULION

Surveyed OCT. 27 1977, by B. SUND