


T. 41 S., R. 8 W., W.M.

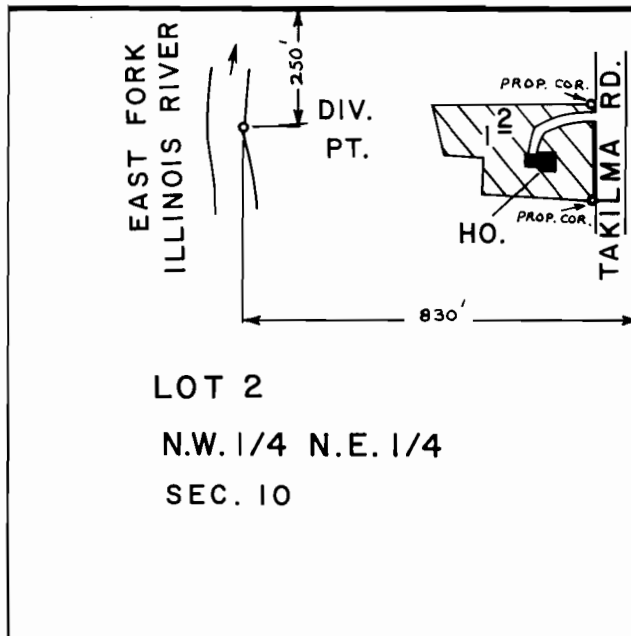

SCALE : 1" = 400 FT.

FINAL PROOF SURVEY
UNDER

Application No. 52734 Permit No. 39370
IN NAME OF

WILLIAM R. & CATHERINE G. DUNHAM

Surveyed JUN. 13 1979, by B. SUND

D.H.M.

P.T.S. - 1979 - 14 - B