


T. 38 S. R. 5 W. W.M.

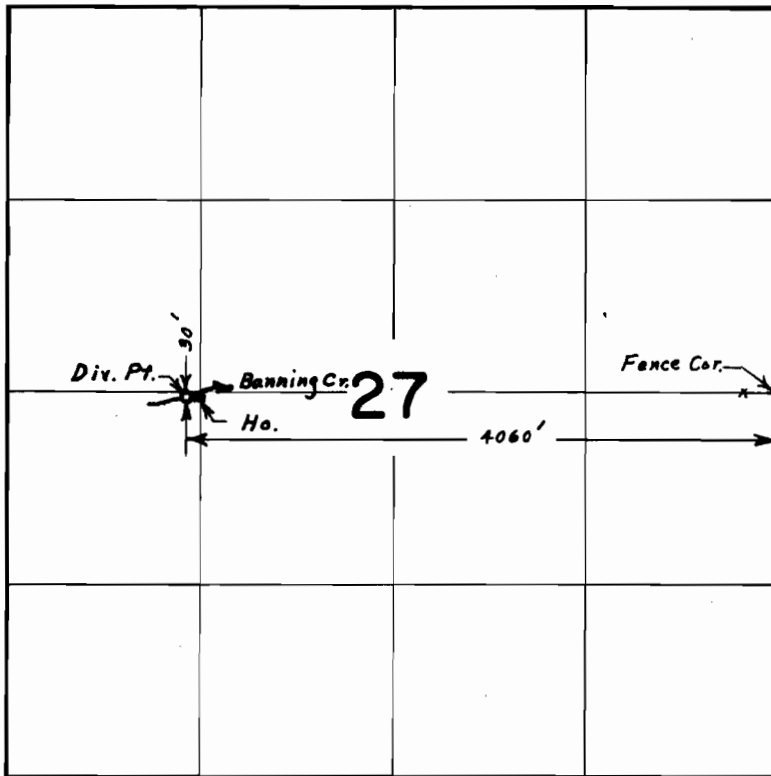

FINAL PROOF SURVEY
UNDER

Application No. 44231 Permit No. 32736
IN NAME OF

..... MS. DEBBIE MILLION

Surveyed Sept. 16, 1975, by L. E. Gould
Inspection: April 4, 1979 by B. R. Sund