


T.37S.,R.6W.,W.M. .

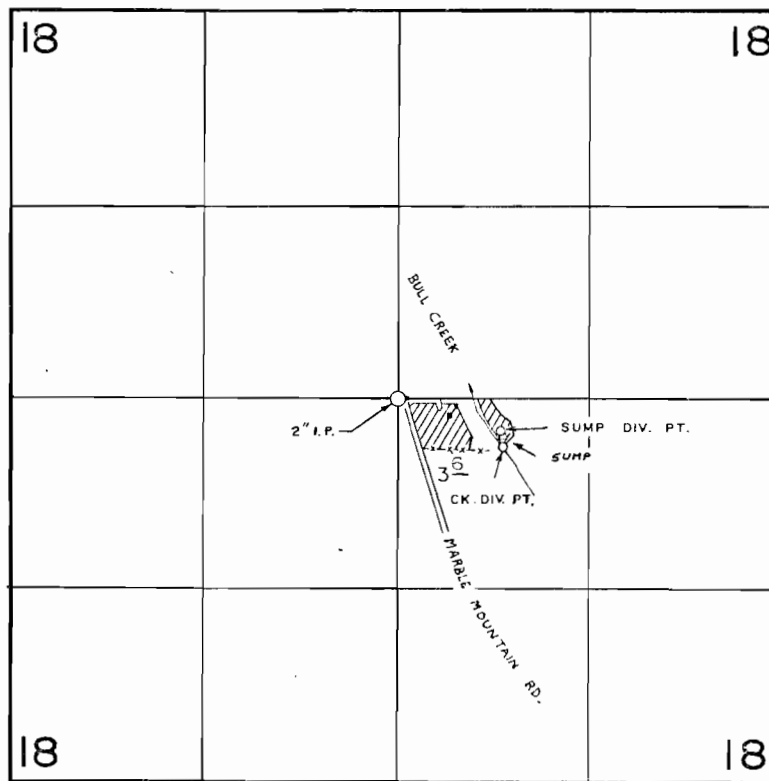

SUMP DIV. PT. LOC.: 225'S. & 705'E. FROM CEN. SEC. 18
CK. DIV. PT. LOC.: 330'S. & 725'E. FROM CEN. SEC. 18

FINAL PROOF SURVEY
UNDER

G-7144 G-6594
Application No. 51644 Permit No. 37399
IN NAME OF

DOUGLAS C. & OPHELIA N. BROWN

Surveyed OCT. 10. 1977, by B. SUND