


T.37S.,R.6W.,W.M.

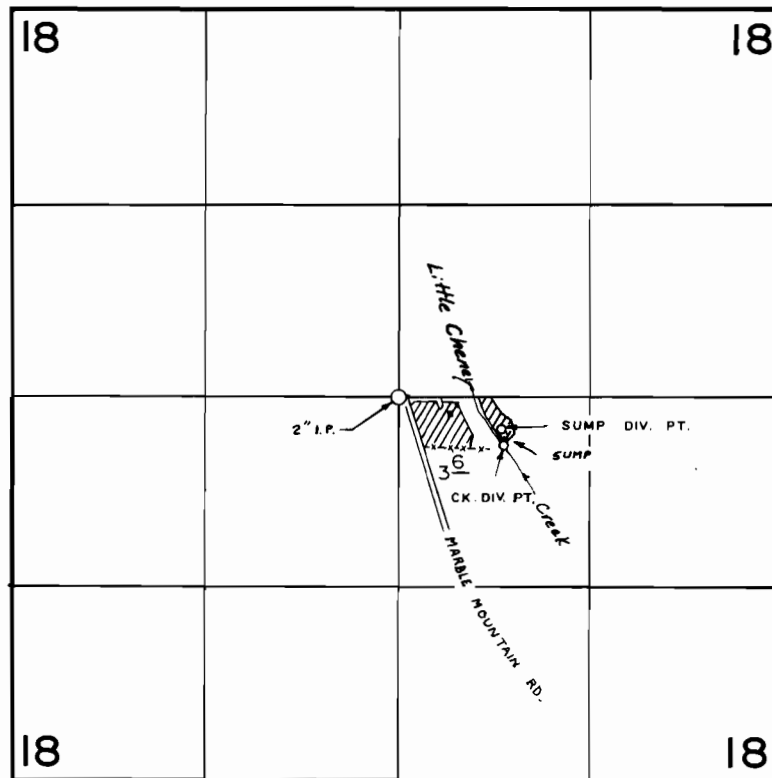

SUMP DIV. PT. LOC.: 225' S. & 705' E. FROM CEN. SEC. 18  
CK. DIV. PT. LOC.: 330' S. & 725' E. FROM CEN. SEC. 18

**FINAL PROOF SURVEY**  
UNDER

G-7144                      G-6594  
Application No. 51644    Permit No. 37399  
IN NAME OF  
DOUGLAS C. & OPHELIA N. BROWN  
Surveyed OCT. 10, 1977, by B. SUND