


T.41S. R.10E. W.M.

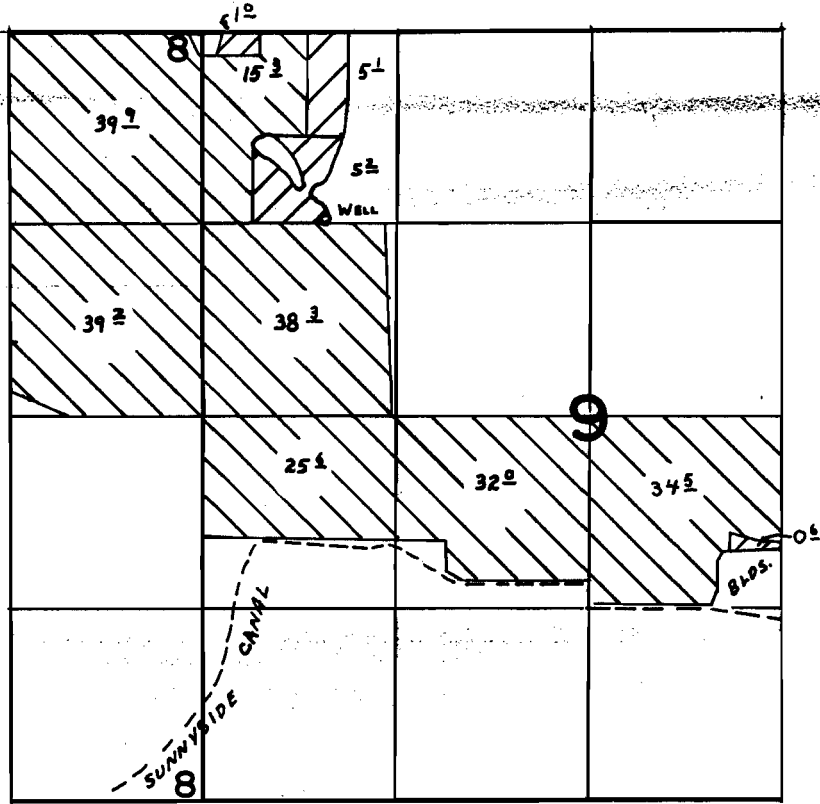

Foot River wells

WELL LOC. 1270'S. & 840'E FROM NW COR. SEC. 9.

-  PRIMARY
-  SUPPLEMENTAL

FINAL PROOF SURVEY UNDER

Application No. G-5843. Permit No. G-5586.
IN NAME OF

.....WENDELL MOORE.....

Surveyed APR. 26. 1976. by L.H. NUNN.....