


G-8486  
49131

# T.41S. R.10E. W.M.

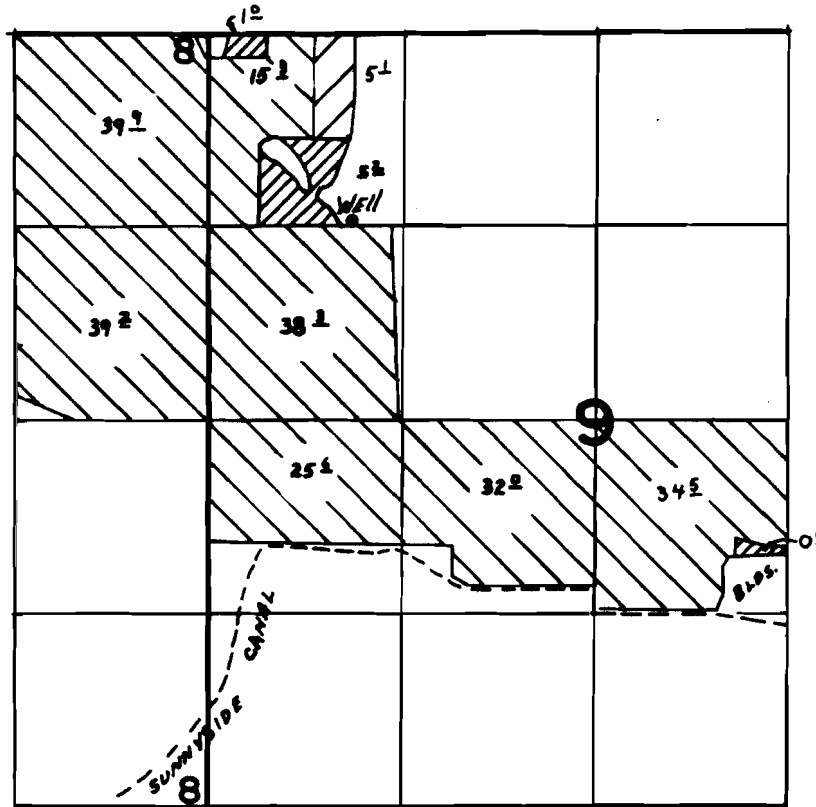

Just As Well

WELL LOC. 1270'S. & 1000'E FROM NW COR. SEC. 9.

- PRIMARY (G-5843)
- SUPPLEMENTAL
- PRIMARY (G-9122)

## FINAL PROOF SURVEY UNDER

Application No. G-9122 G-5843 Permit No. G-8486 ✓  
G-5586  
IN NAME OF

WENDELL MOORE

Surveyed APR. 26 1976. by L.H. NUNN  
Sept. 19 1979 C.R. RODRIGUEZ