


T.9S. R.3W., W.M.

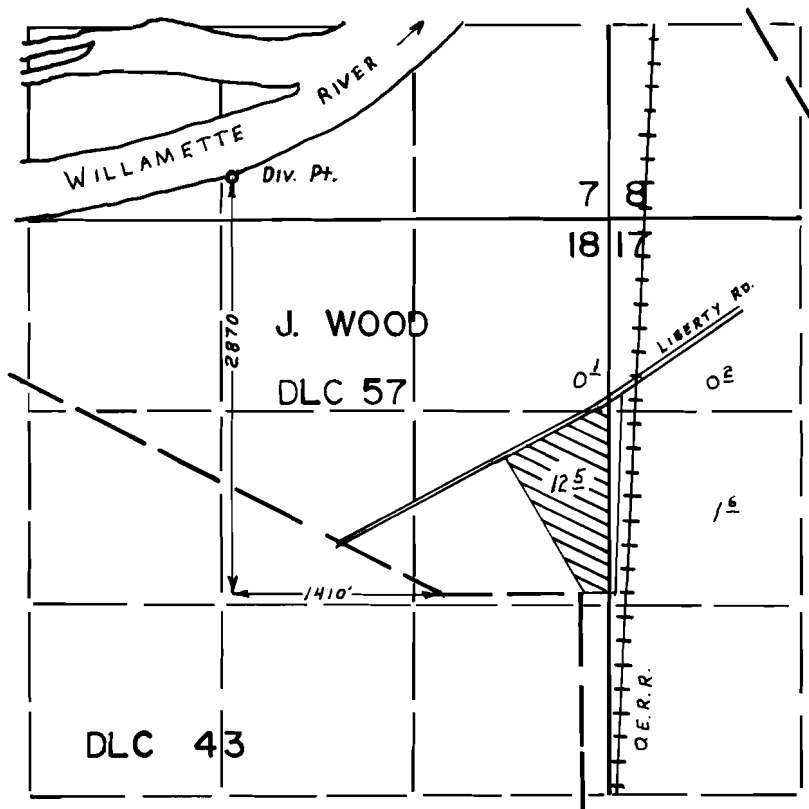

FINAL PROOF SURVEY UNDER

Application No. 55443 Permit No. 41821
IN NAME OF

Sidney Farms

Surveyed MAY 25 1978, by S.P. APPLIGATE