


# T.6&7S.,R.IW.,W.M.

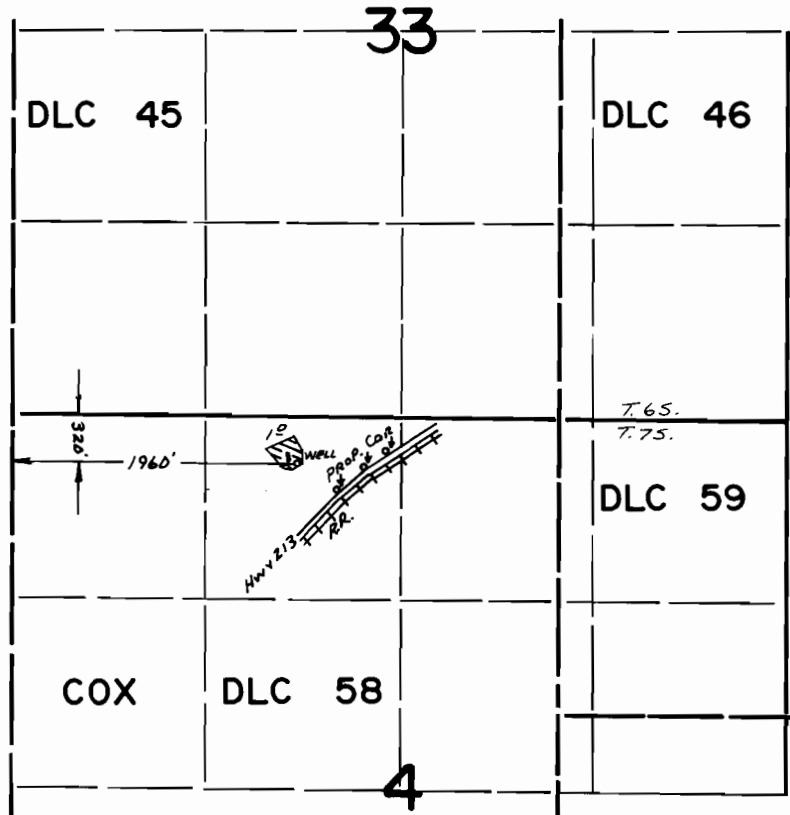

## FINAL PROOF SURVEY UNDER

Application No. G-6544 Permit No. G-6149.  
IN NAME OF

.....RONALD GENE MAURER.....

Surveyed OCT. 8 1976, by L. Toll  
" May 31, 1979 by L. Nunn