


G-5051

49140

T. 2N. R. 30E. W.M.

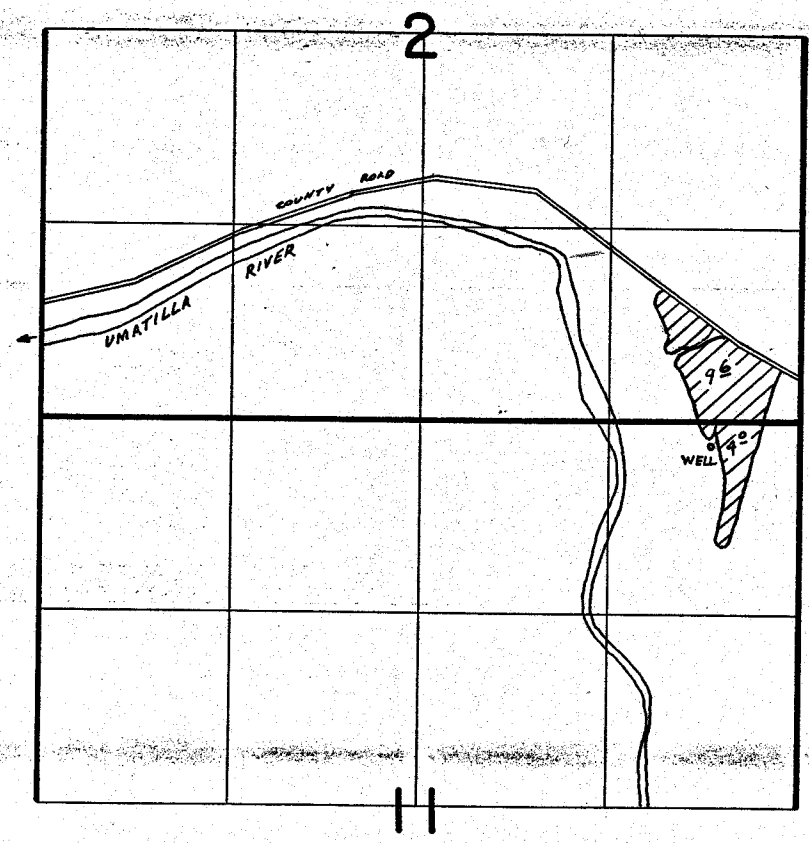

WELL LOC. 180'S & 620'W FROM SE COR OF SEC 2

FINAL PROOF SURVEY
UNDER

Application No. G-5988... Permit No. G-5051...
IN NAME OF

ROBERT U. GENTNER

Surveyed 8-11..... 1978, by R. BARWIN.....

FL10A-12 V.L.C.