


T. 2N. R. 33E. W. M.

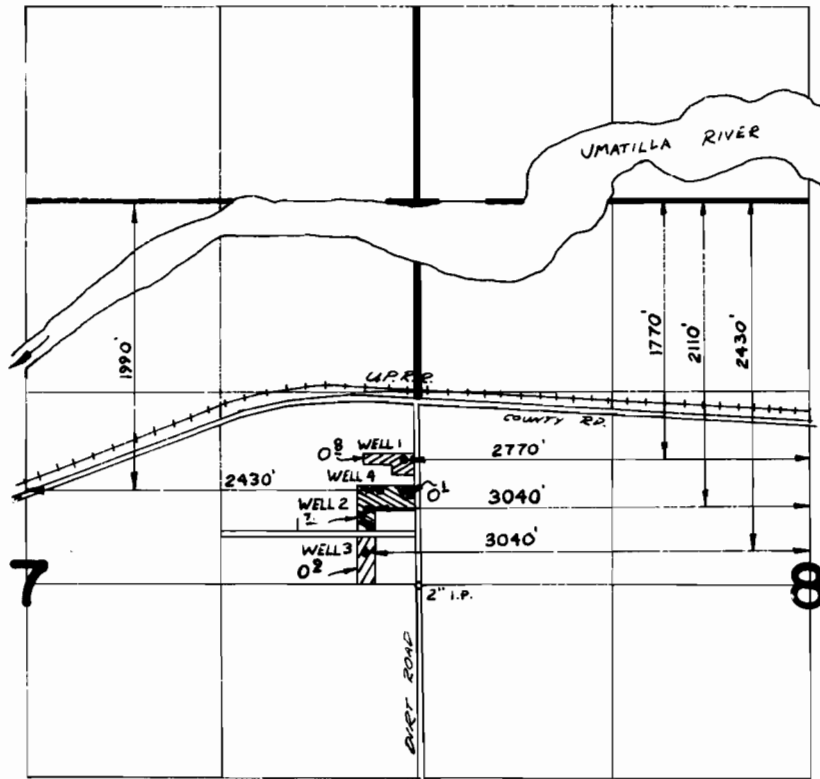

FINAL PROOF SURVEY
UNDER

Application No. **G-5200** Permit No. **G-5068**
IN NAME OF

ANTHONY JONES, ARTHUR GREENFIELD, PAUL ASCUENA

Surveyed 8-8 1978, by J. Church