


T. 2N. R. 33E. W.M.

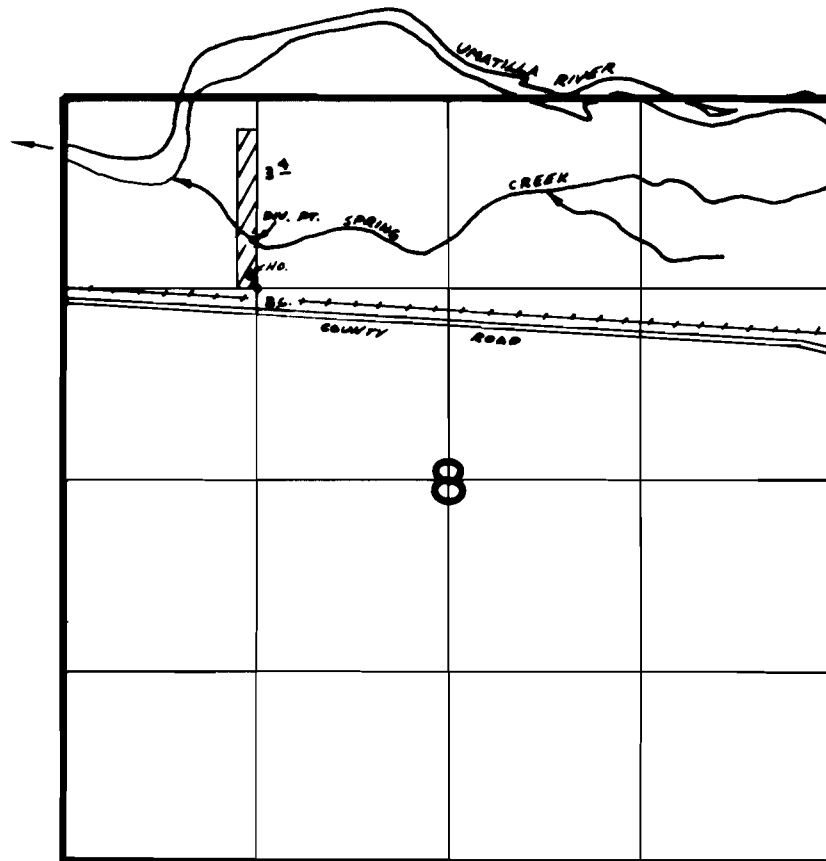

DIVERSION POINT LOCATED 970'S. 11300'E. FROM NW COR SEC B

FINAL PROOF SURVEY
UNDER

Application No. 53046..... Permit No. 40031.....
IN NAME OF

.....**ALVIN R. KREGER**.....

Surveyed 1-31..... 1979., by **V. CHURCH**.....