


P-41737
49143

T.12S. R.20E. W.M.

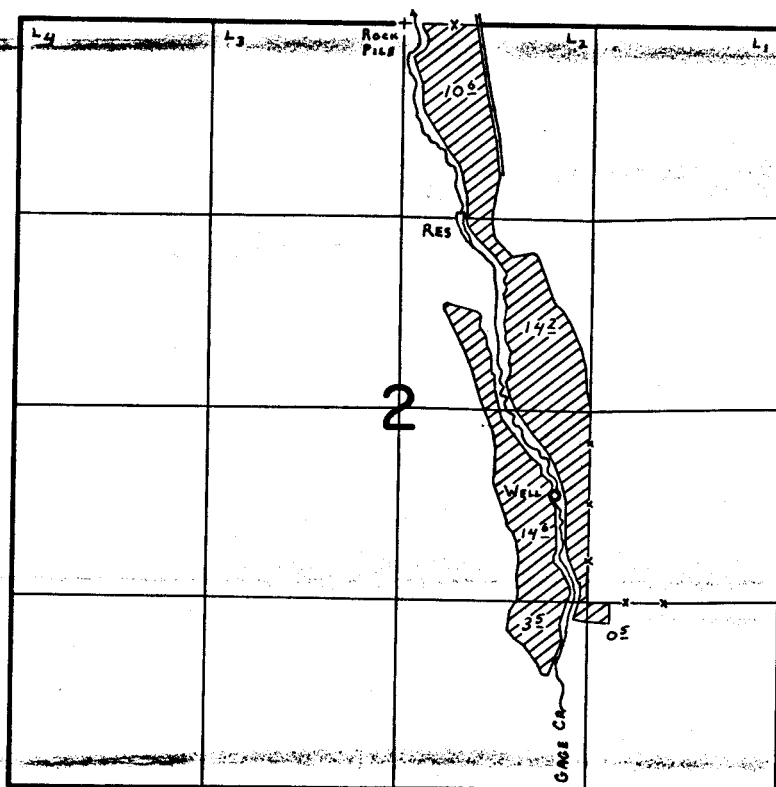

DAM Loc: 1300'S. & 410'E. } BOTH FROM N. 1/4 COR. SEC. 2.
WELL Loc: 3240'S. & 1080'E. }

FINAL PROOF SURVEY UNDER

Application No. 55726. Permit No. 41737....
IN NAME OF

ROBERT E. WOODWARD

Surveyed July 26, 1979, by G. L. HUGHES...