

RECEIVED


OCT 4 1978

WATER RESOURCES DEPT.
SALEM, OREGON

T12S R22E W.M.

Scale 4" = 1 mi

Div No. 1- 1360' S & 430' W from NE cor Sec 34
Div No. 3- 80' S & 1080' E from NW cor Sec 26

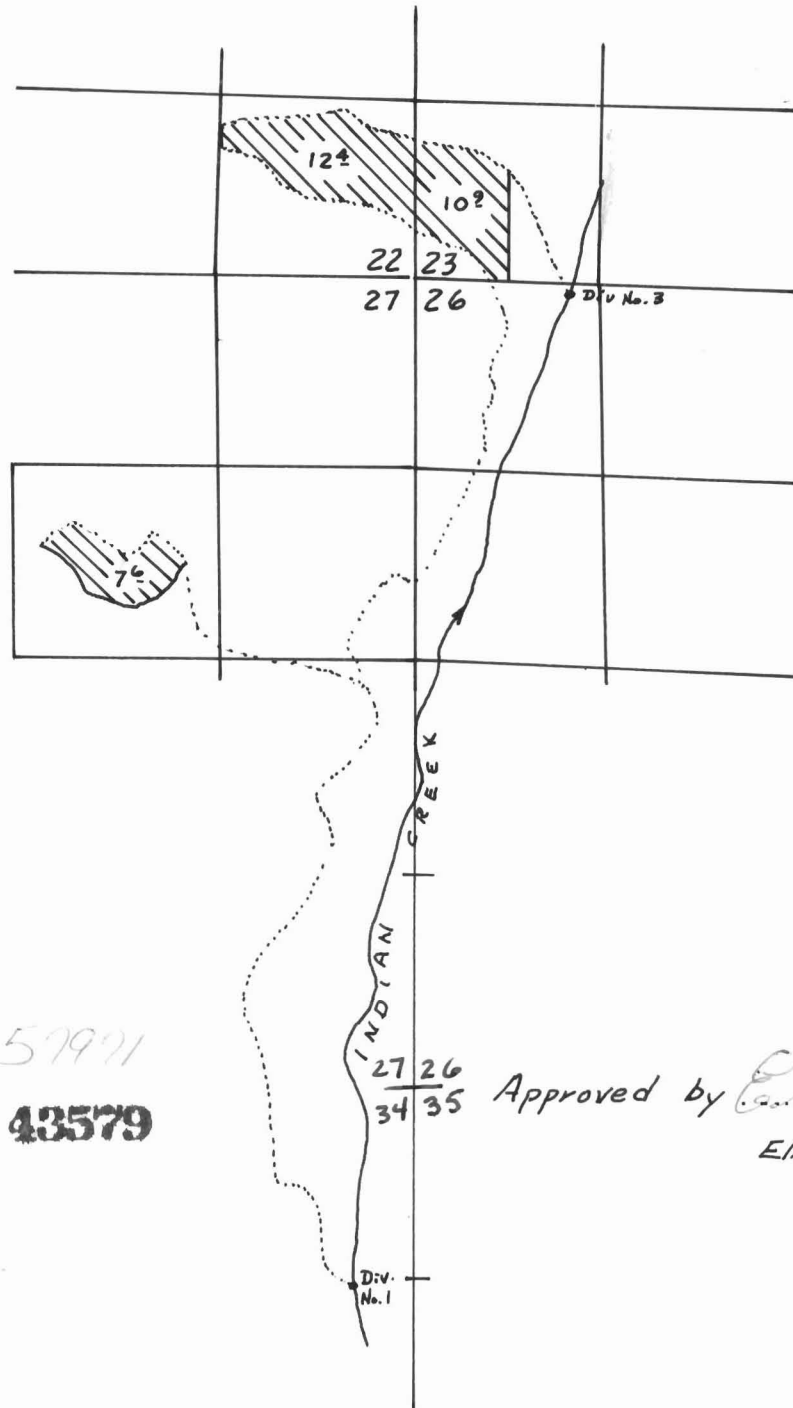

Application No. 57921
Permit No. 43579

Approved by *Elmer J. Jackson*
Elmer J. Jackson