


T. 7S. R. 38E., W.M.

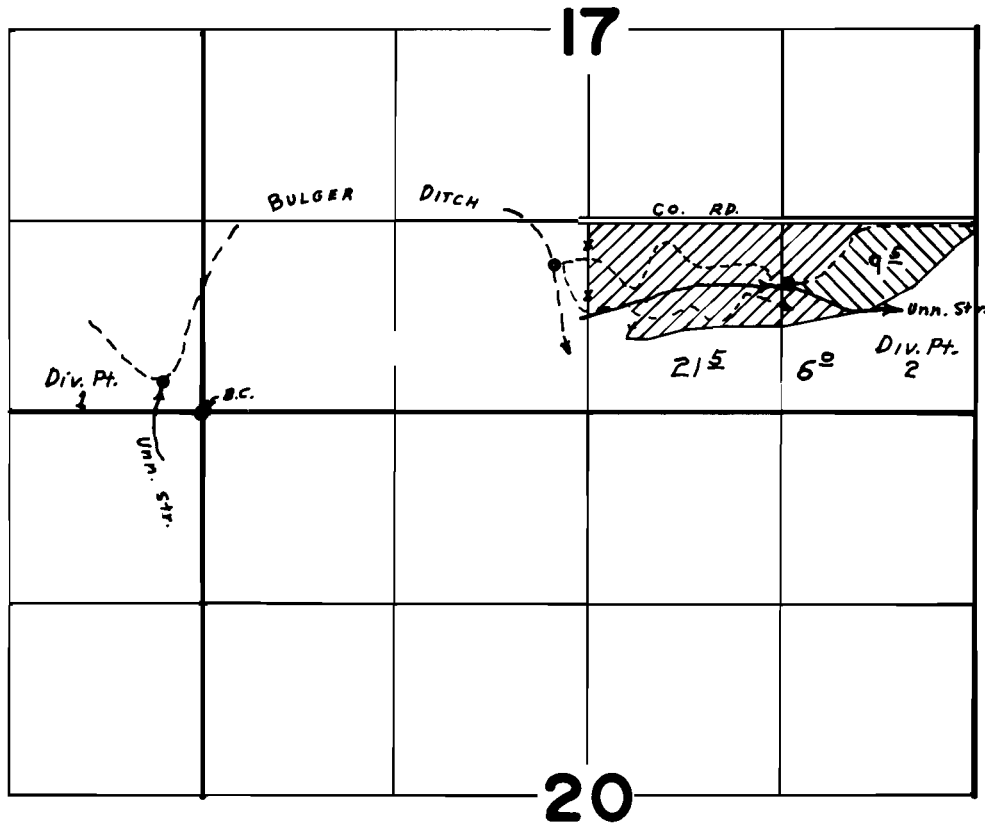

Div. 1 Loc. 200' N. & 270' W. Both From S.W. Cor. Sec. 17
 Div. 2 Loc. 890' N. & 400' E.

FINAL PROOF SURVEY UNDER

Application No. 42660 42742 Permit No. 31882 31924
 IN NAME OF

Darik V. Mechau

Surveyed MAY 18 1970, by L. E. GOULD
 JULY 26, 1979 - V. CHURCH & D. JARRETT