


T. 8S. R. 39E. W.M.

NE 1/4 SW 1/4 SEC 30

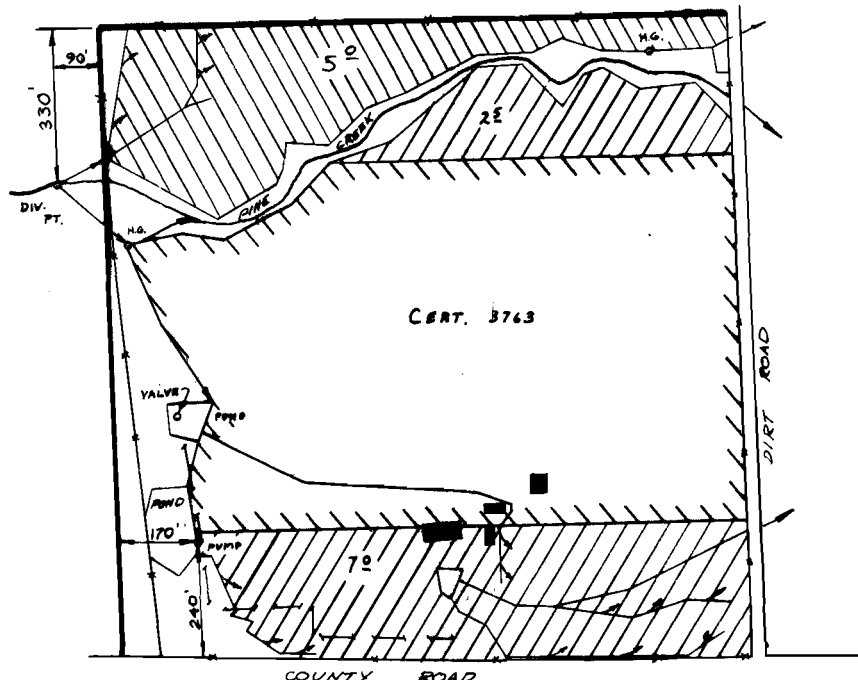

PERMIT 42334 PERMIT G-7690
PRIM SUPP'L SUPP'L

Scale: 1" = 400'

FINAL PROOF SURVEY
UNDER

G-8252 G-7690
Application No. 55967 Permit No. 42344
IN NAME OF

RONALD E. JOHNSON

Surveyed 6-8 1978, by R. BARWIN