


Application No. 68252
Permit No. G 7690

T.8S.R.39E.W.M.

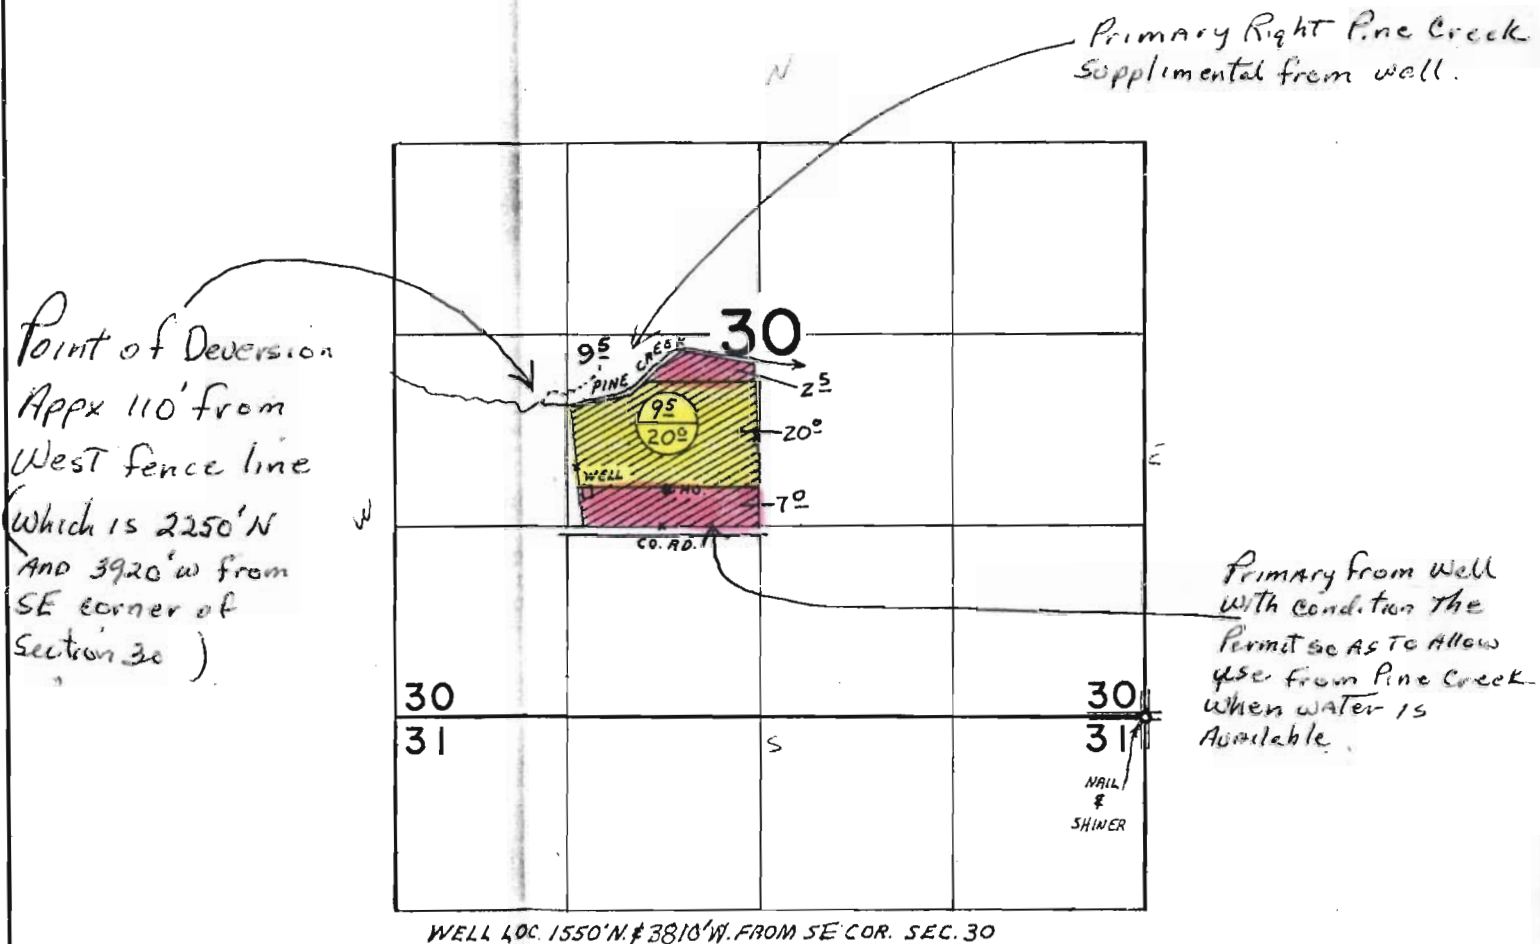

FINAL PROOF SURVEY
UNDER

Application No. ~~G-3729~~ Permit No. ~~G-3771~~

IN NAME OF

RONALD E. JOHNSON

Surveyed JULY 9, 1970, by L.E. GOULD

RECEIVED

NOV 28 1977

WATER RESOURCES DEPT
SALEM, OREGON