


# T.4S.R.1E.W.M.

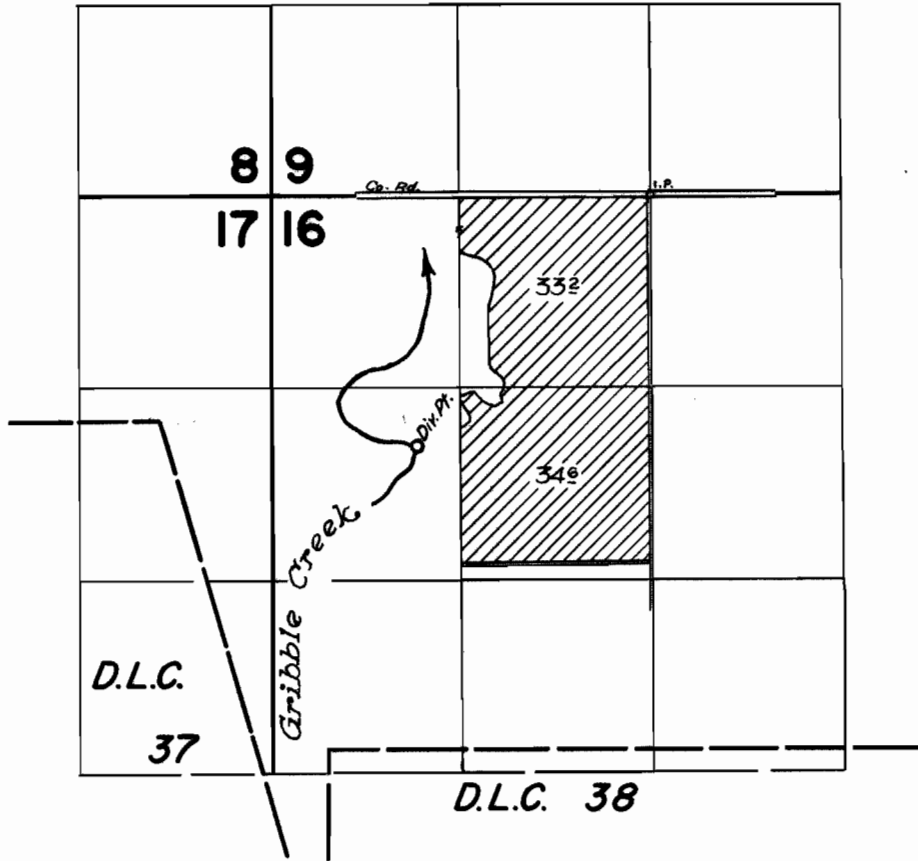

## FINAL PROOF SURVEY UNDER

Application No. 37308... Permit No. 27794...  
IN NAME OF

A. E. HARMS

Surveyed April 18, 1963., by *L. Jackson*