


T.40S. R.13W. W.M.

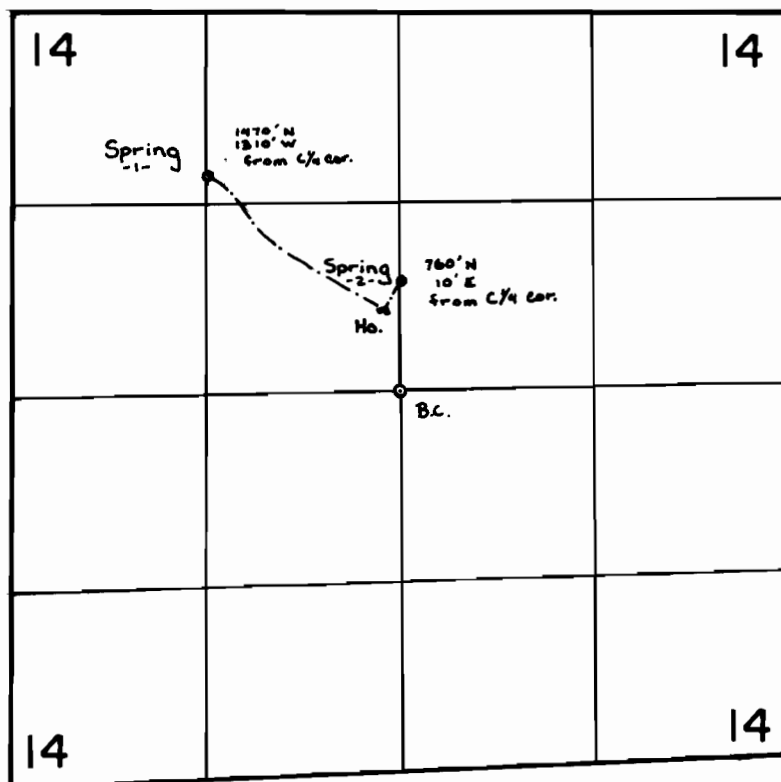

SCALE: 4" = 1 mi.

FINAL PROOF SURVEY
UNDER

Application No. 53912 Permit No. 40462
IN NAME OF

GEORGE E. & VIOLA J. MOSIER

Surveyed Nov. 30 1977, by D. Sparks