


T24SR5WWM

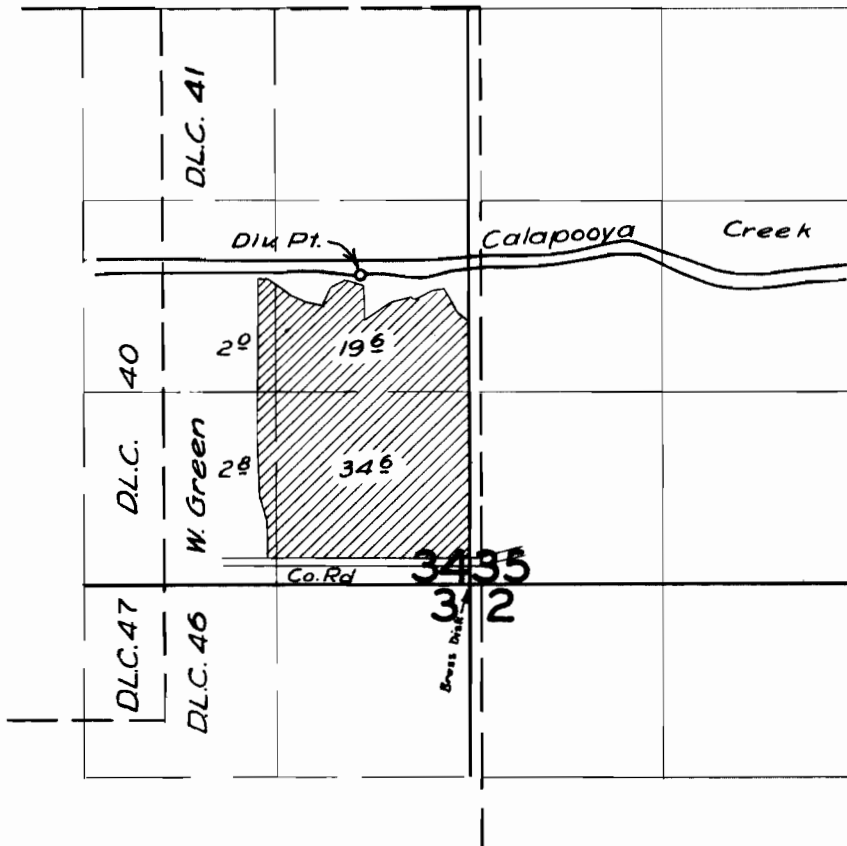

FINAL PROOF SURVEY UNDER

Application No. 25295 Permit No. 19857
IN NAME OF

L. T. Howard

Surveyed Aug. 19, 1957, by M. Bish