


T. 28 S., R. 8 & 7 W., W.M.

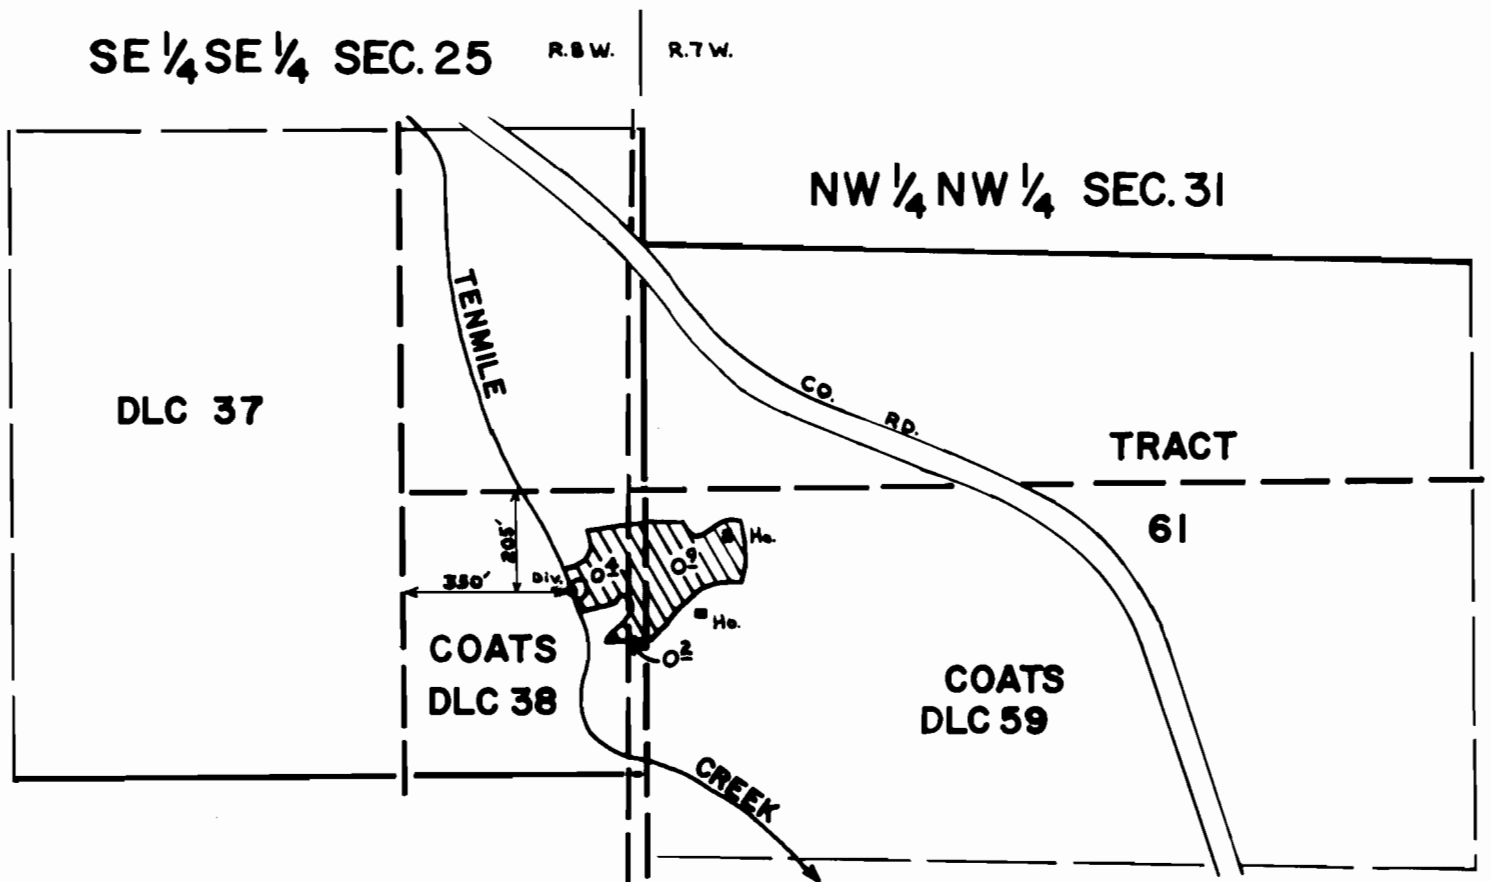

SCALE: 1" = 400'

FINAL PROOF SURVEY
UNDER

Application No. 49340 Permit No. 36990
IN NAME OF

WENDELYN O. KNAPP

Surveyed FEB. 23 1978, by D.W. SPARKS