

T. 358 36 S. R. 33E. W.M.

FINAL PROOF SURVEY

UNDER

APPLICATION No. 28563

PERMIT No. 22338


IN NAME OF

CATLOW VALLEY RANCHES, INC.

SURVEYED OCT. 3-10, 1967

BY W. J. Ruppert

THIS PERMIT
PRIOR RIGHTS

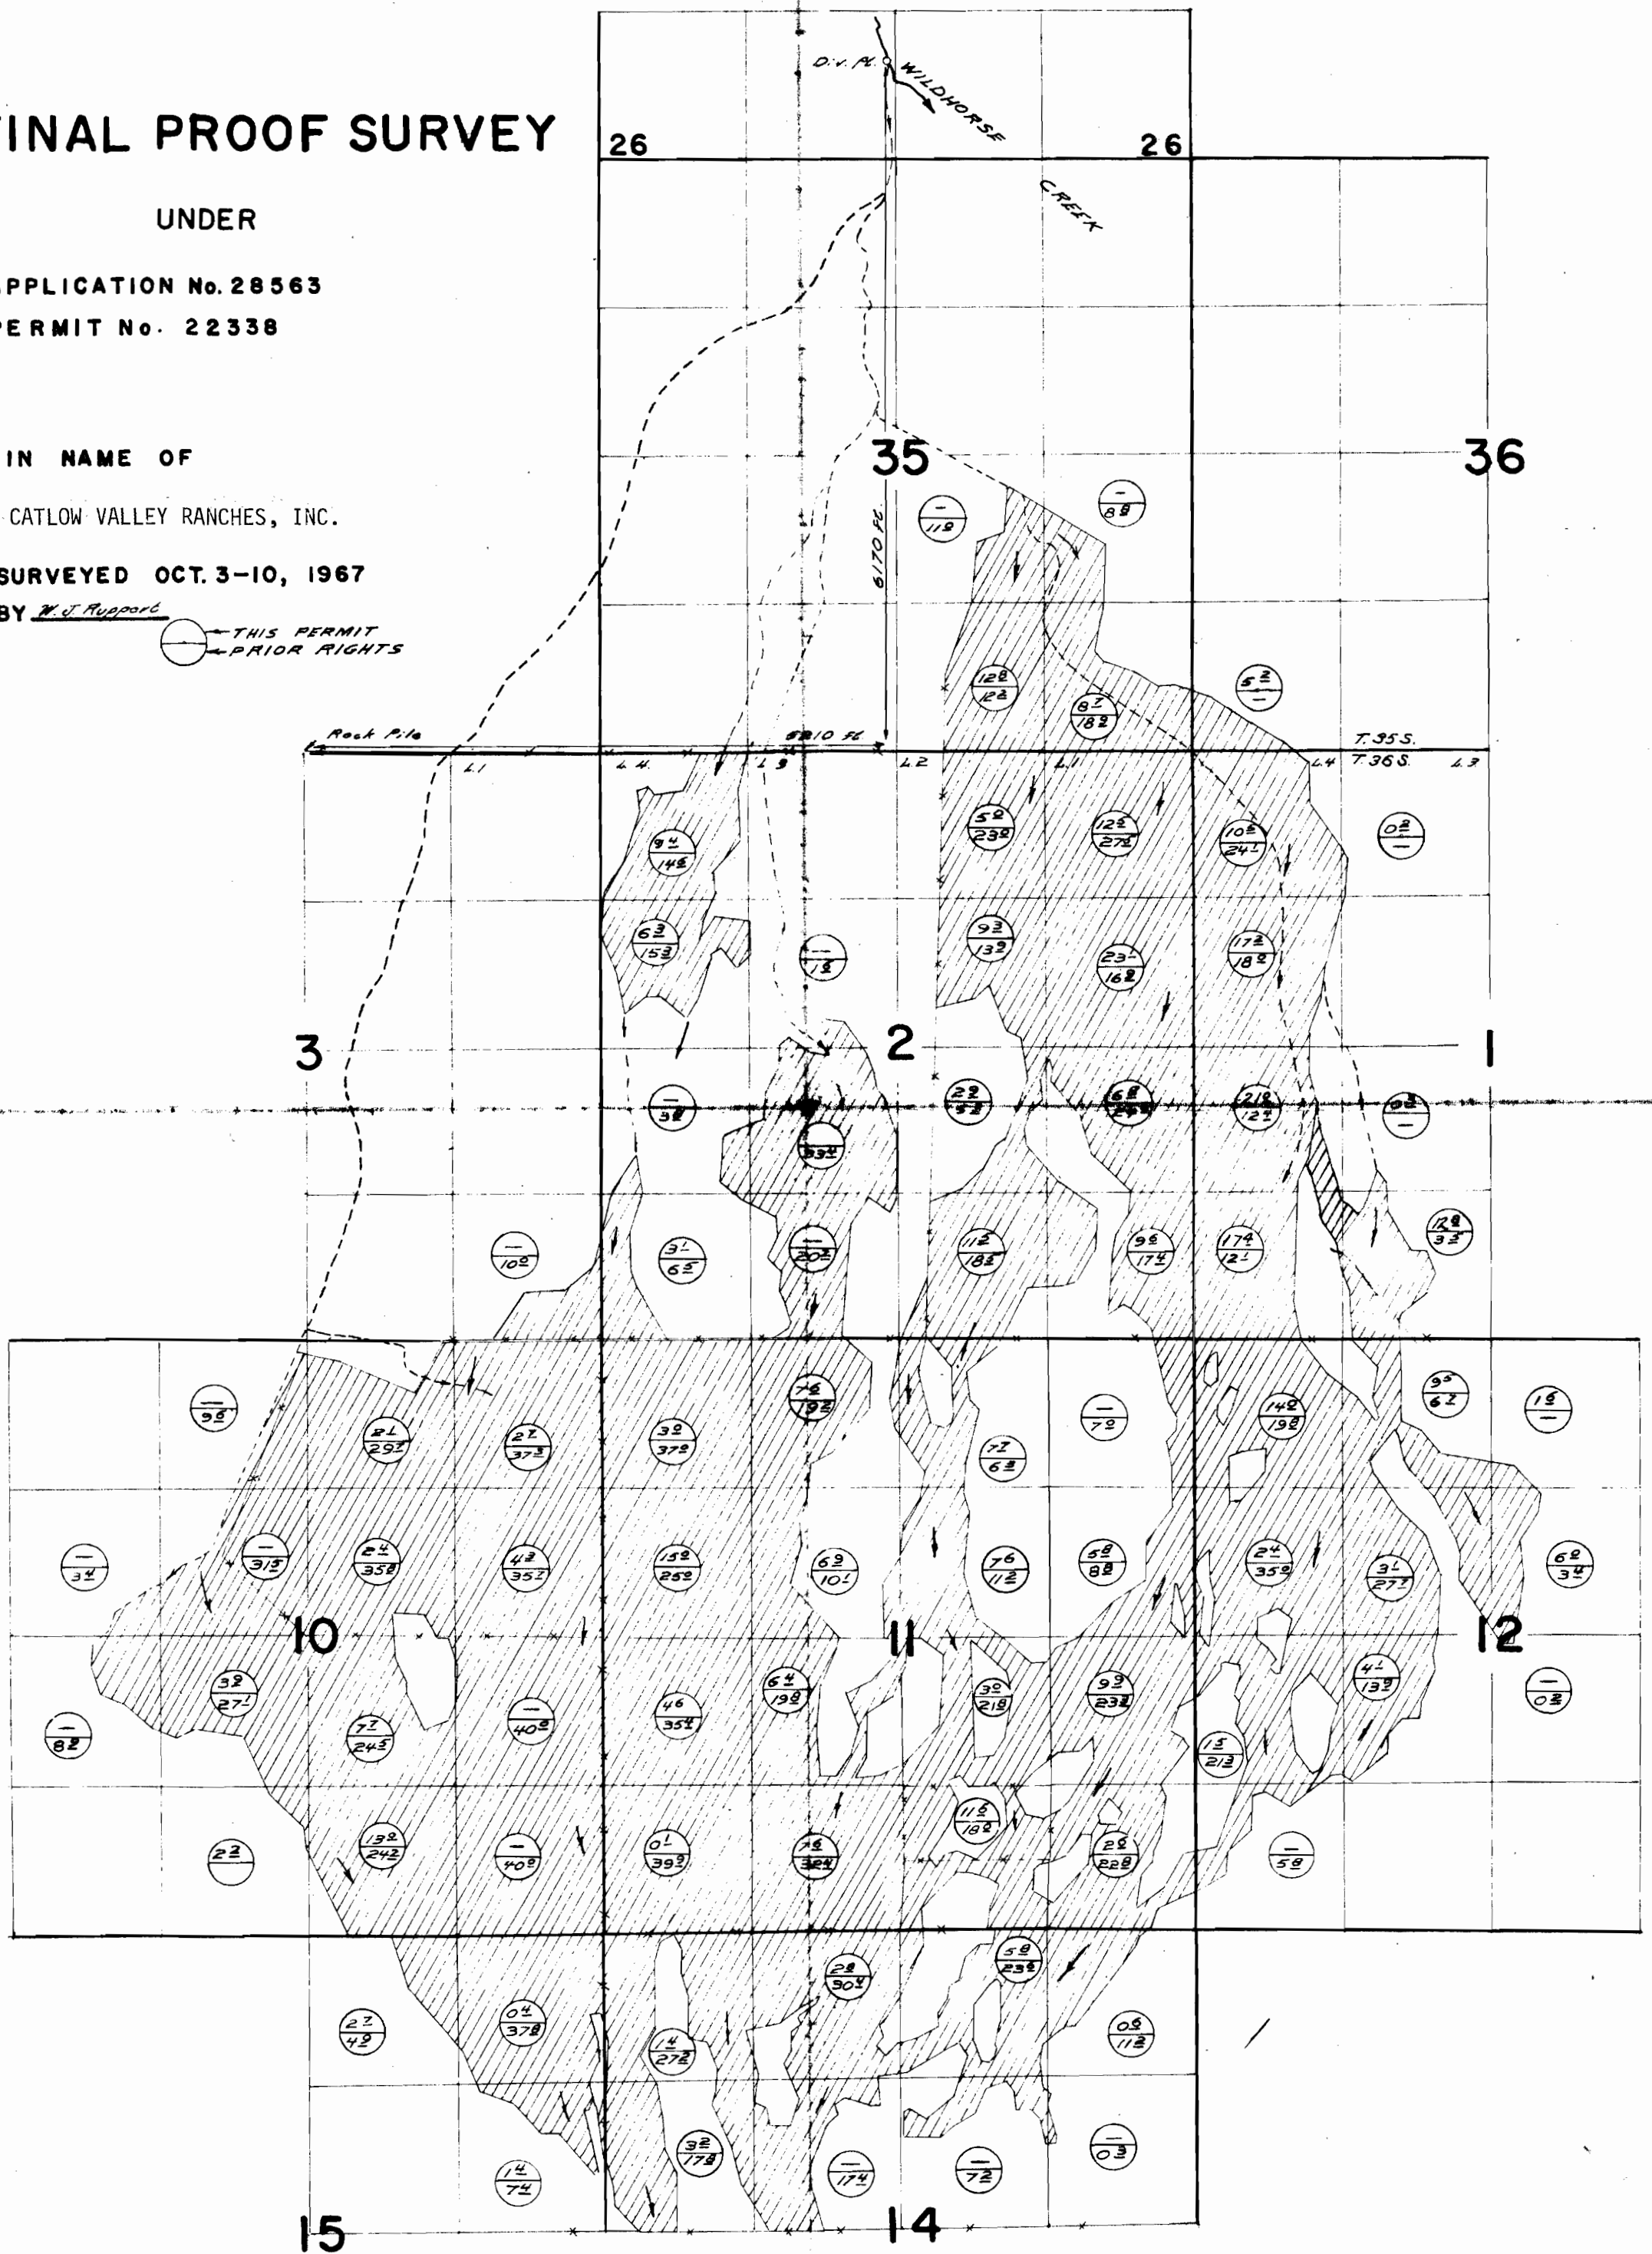

T. 35 S. R. 35 E. W. M.

Ignore hand-written
hatching for App. 62436

RECEIVED

SEP 2 - 1981

WATER RESOURCES DEPT.
SALEM, OREGON

Application No. 62436
Permit No. 46062

FINAL PROOF SURVEY

UNDER

APPLICATION NO. 28563 PERMIT NO. 22338
Cert. 49182

IN NAME OF

CATLOW - STEENS CORP.

SURVEYED OCT. 21-22, 1965 BY R. JACKSON
OCT. 3-10, 1967 BY W. J. RUPPERT



PRIOR RIGHTS
THIS PERMIT

SCALE 4" = 1 MILE

