


T.34S.R.1W.W.M.

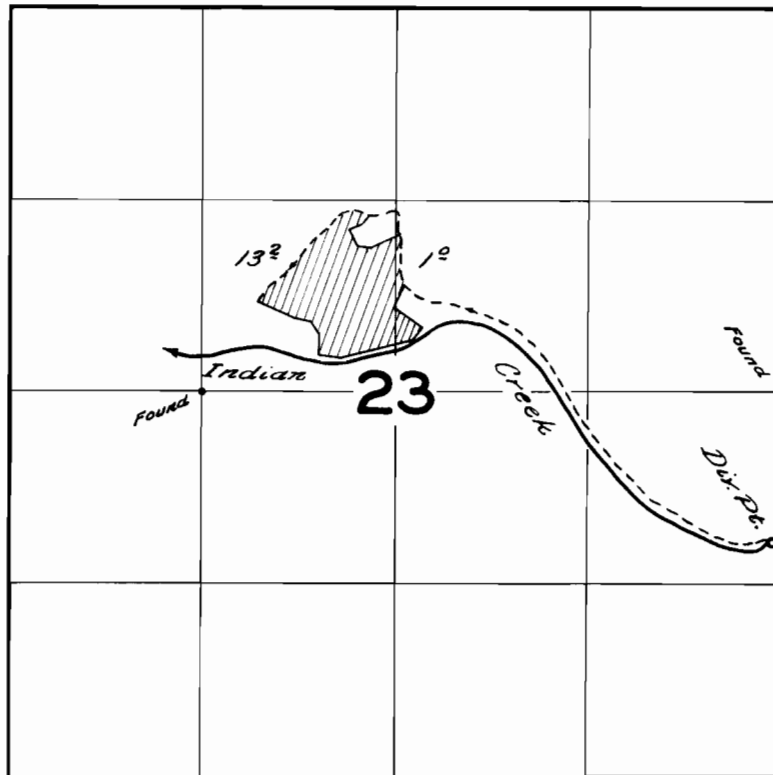

FINAL PROOF SURVEY UNDER

Application No. *28541* Permit No. *22330*
IN NAME OF

.....*Charles L. Brewer*.....

Surveyed *May 9* 1959, by *C. O. Bunker*.....