



T.34S. R.1 W. W. M.

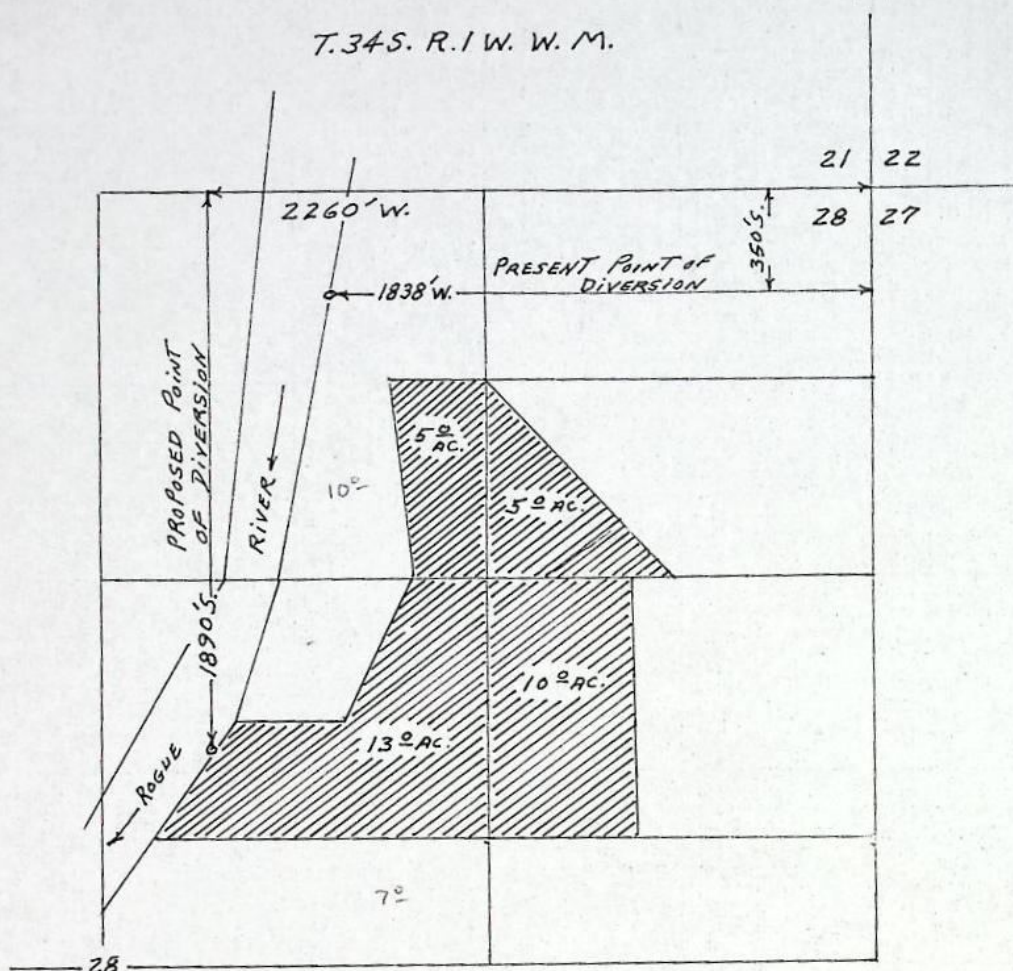

MAP TO ACCOMPANY APPLICATION OF
TRUMAN DEAN COLLINS AND Z. IDELLE COLLINS
FOR CHANGE IN POINT OF DIVERSION ON
CERT. # 10523 PRIORITY NOV. 18 1922

RECEIVED
JUN 15 1976
WATER RESOURCES DEPT
SALEM, OREGON


SCALE 8" = 1 MILE

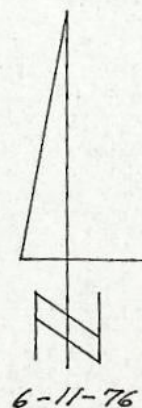

T-3426

T.34 S., R.1W., W.M.

SEC. 28

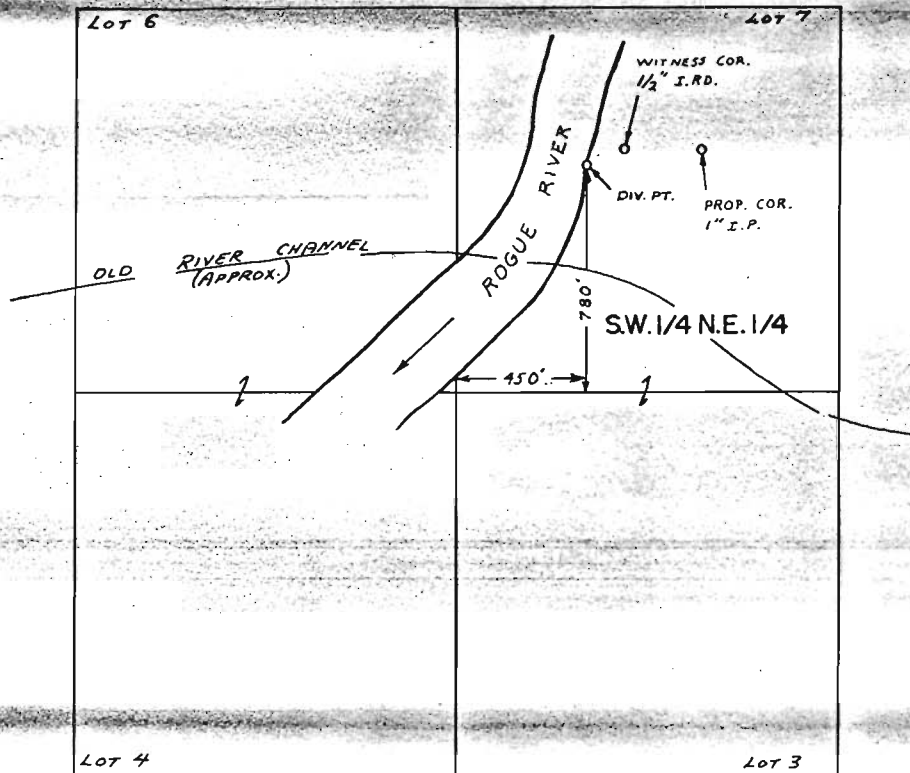

SCALE : 1" = 660 FT.

FINAL PROOF SURVEY
UNDER

Transfer No. ~~3425~~

Transfer No. 3426

Application No. 8726 Permit No. 5695 - Cert. No. 49186
IN NAME OF

TRUMAN DEAN & Z. IDELLE COLLINS

Surveyed AUG. 16 1978 by B. SUND

*This cert. CIPD
approved by order of
Director 10-26-79
and together with
Cert. 48962, Vol. 42
and two orders of
Director of 10-26-69
supersede Cert. 10523, Vol. 10.*