


T. 35 S., R. 2 W., W. M.

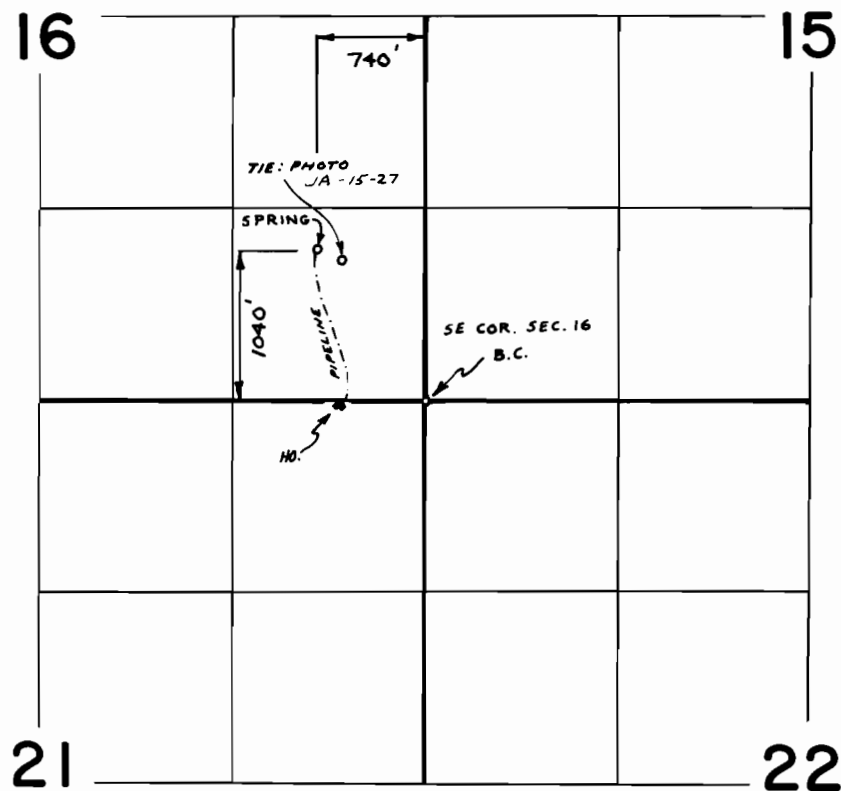

FINAL PROOF SURVEY
UNDER

Application No. 48812 Permit No. 36590
IN NAME OF

LAVERN G. & AGDA A. ADAMS

Surveyed APR. 12 1978, by B. SUND