


T. 39 S., R. 3 W., W.M.

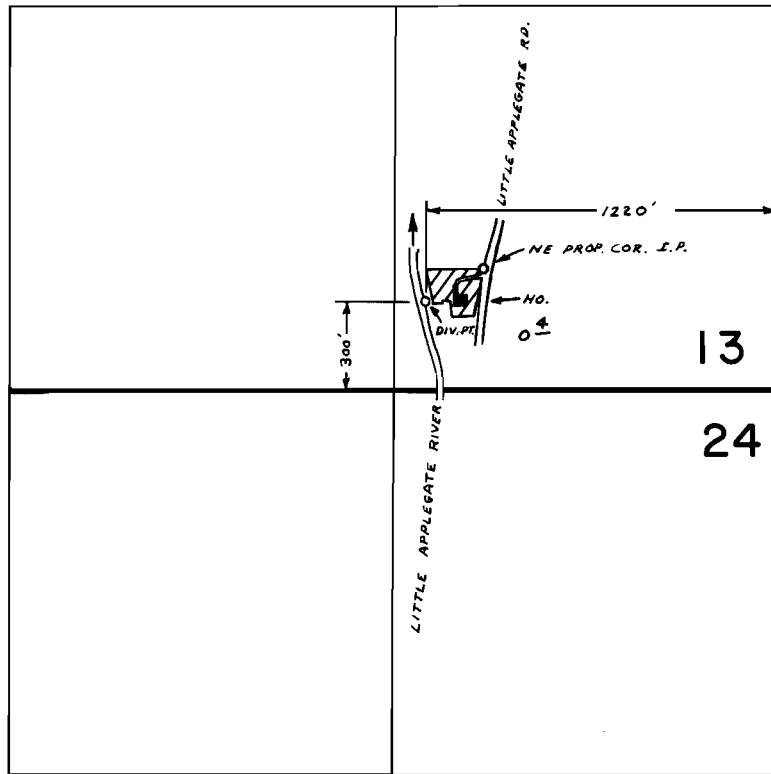

SCALE: 1" = 660 FT.

**FINAL PROOF SURVEY**  
UNDER

Application No. 50359 Permit No. 38016  
IN NAME OF

*Geoffrey R. Wycalf*

Surveyed JUN. 8 1978, by B. SUND