


T.39 S.R.7 W.W.M.

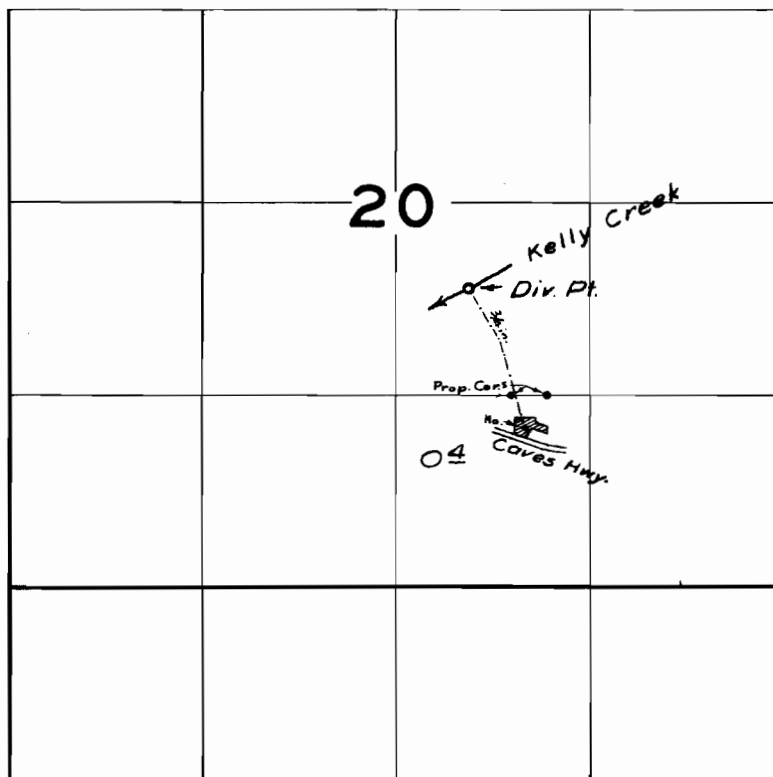

FINAL PROOF SURVEY
UNDER

Application No. 24739 Permit No. 19927
IN NAME OF

WAYNE J. FOSTER

Surveyed 15 July 1959, by M. Bish