


T. 36 S., R. 7 W., W.M.

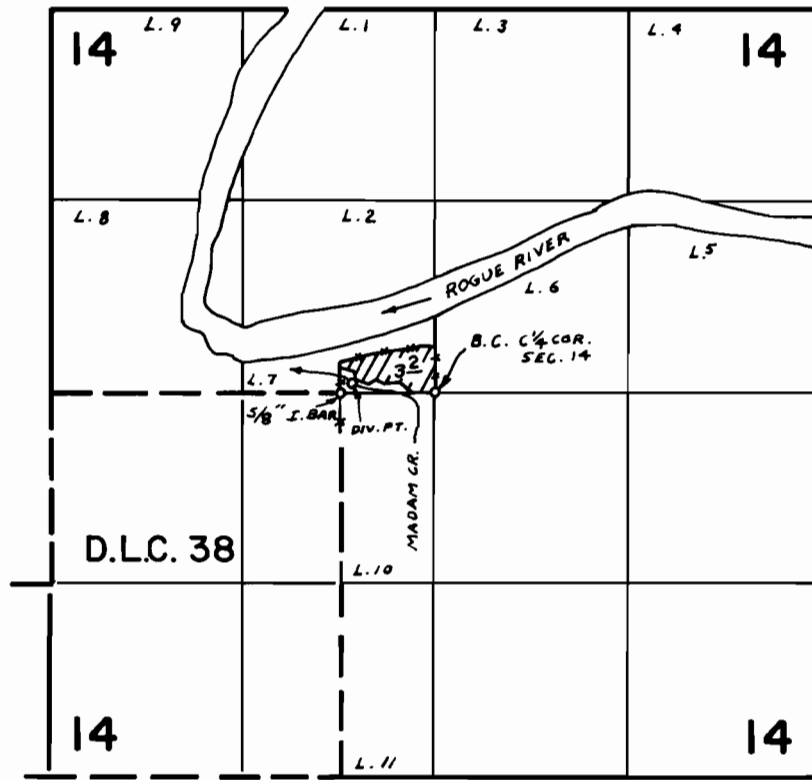

DIV. PT. LOC. : 60' N. & 70' E. FROM NE COR. D.L.C. 38

FINAL PROOF SURVEY UNDER

Application No. 50800 Permit No. 37760
IN NAME OF

LLOYD O. GUINN

Surveyed NOV. 9 77 by B. SUND
1977