


T. 35 S., R. 6 W., W.M.

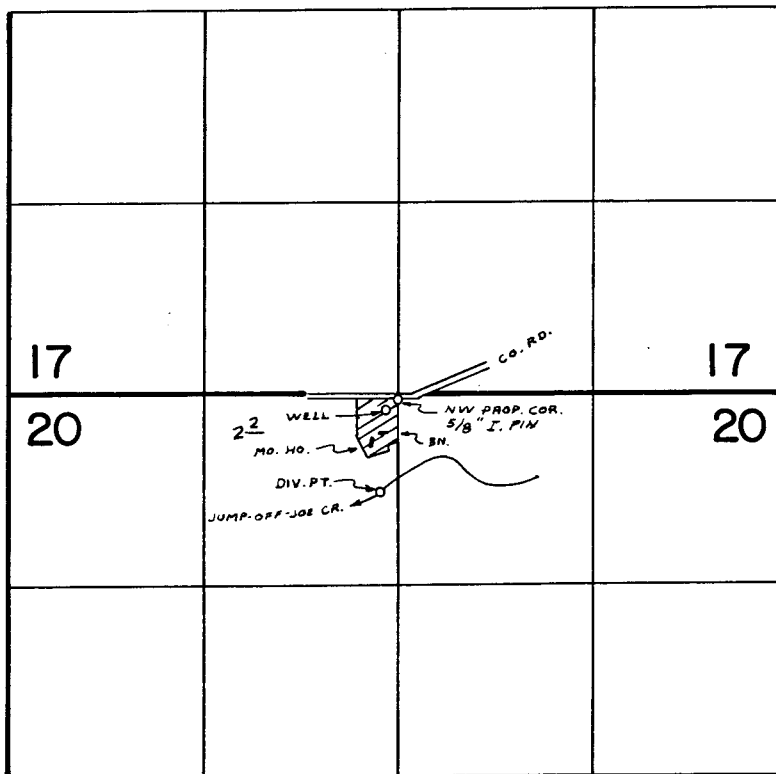

WELL LOC.: 100' S & 70' W FROM N 1/4 COR. SEC. 20
 DIV. PT. LOC.: 580' S & 120' W FROM N 1/4 COR. SEC. 20

RECEIVED

MAY 19 1980

WM. DIST. 14
 GRANTS PASS, ORE

FINAL PROOF SURVEY UNDER

Application No. 50565 Permit No. G-6150 G-5821 SUPPL.
38177 PRIMARY
 IN NAME OF

EARL A. BOLES

Surveyed NOV. 2 77 by B. SUND
 19....., by