


# T. 35 S., R. 6 W., W.M.

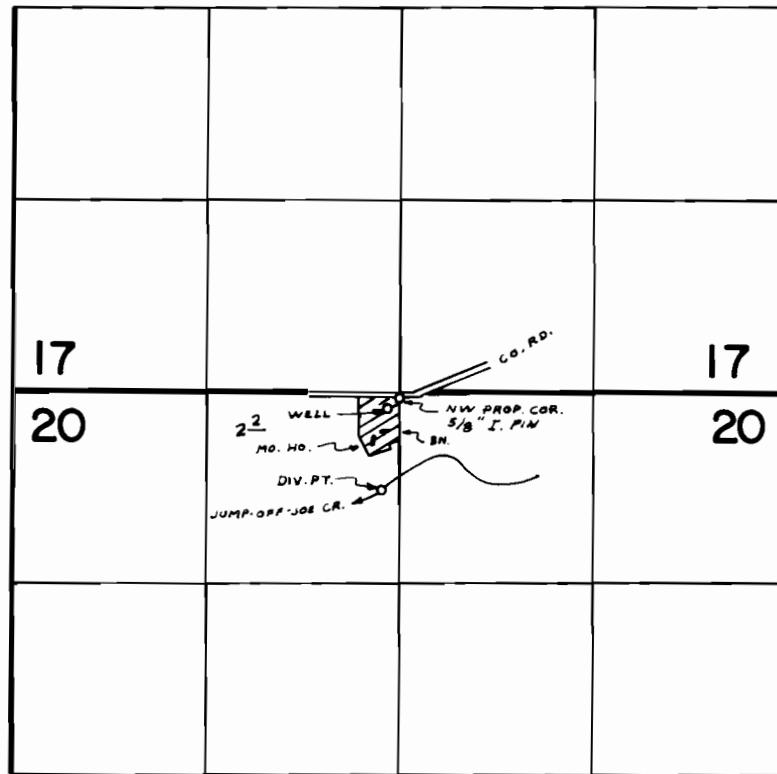

WELL LOC.: 100' S & 70' W FROM N 1/4 COR. SEC. 20  
 DIV. PT. LOC.: 680' S & 120' W FROM N 1/4 COR. SEC. 20

## FINAL PROOF SURVEY UNDER

Application No. 50565 Permit No. 38177 G-6150 G-5821 SUPPL. PRIMARY

IN NAME OF  
EARL A. BOLES

Surveyed NOV. 2 77 by B. SUND  
19.....