


T.39S.,R.5W.,W.M.

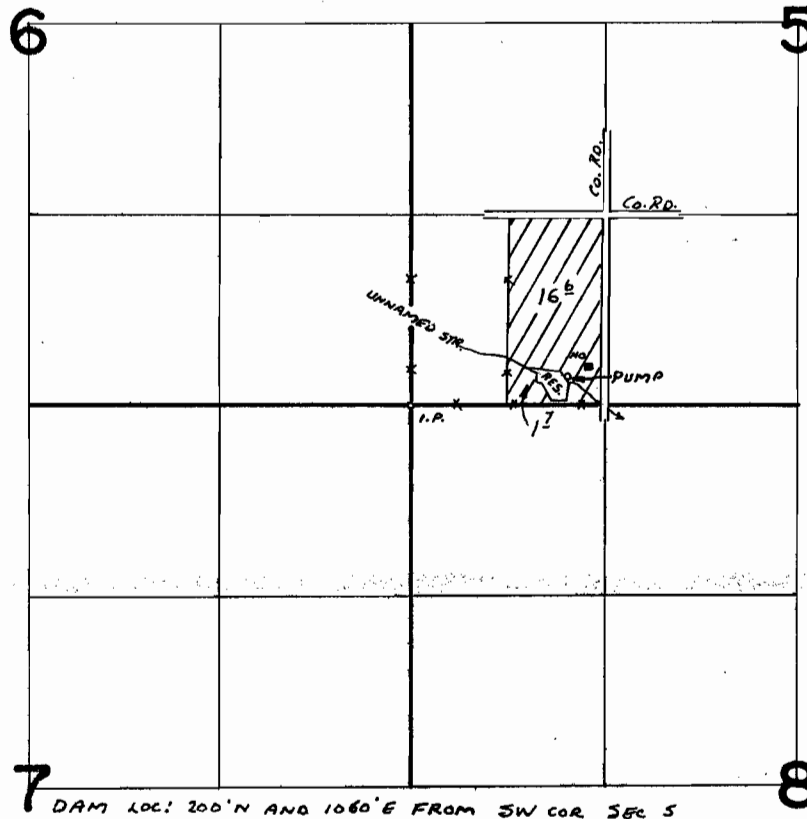

FINAL PROOF SURVEY

UNDER

Application No. R-42885 43124 Permit No. R-4895 32191

IN NAME OF

LEO DUNTLEY

Surveyed SEPT. 11 19 74, by L. Toll