


T.39S.,R.5W.,W.M.

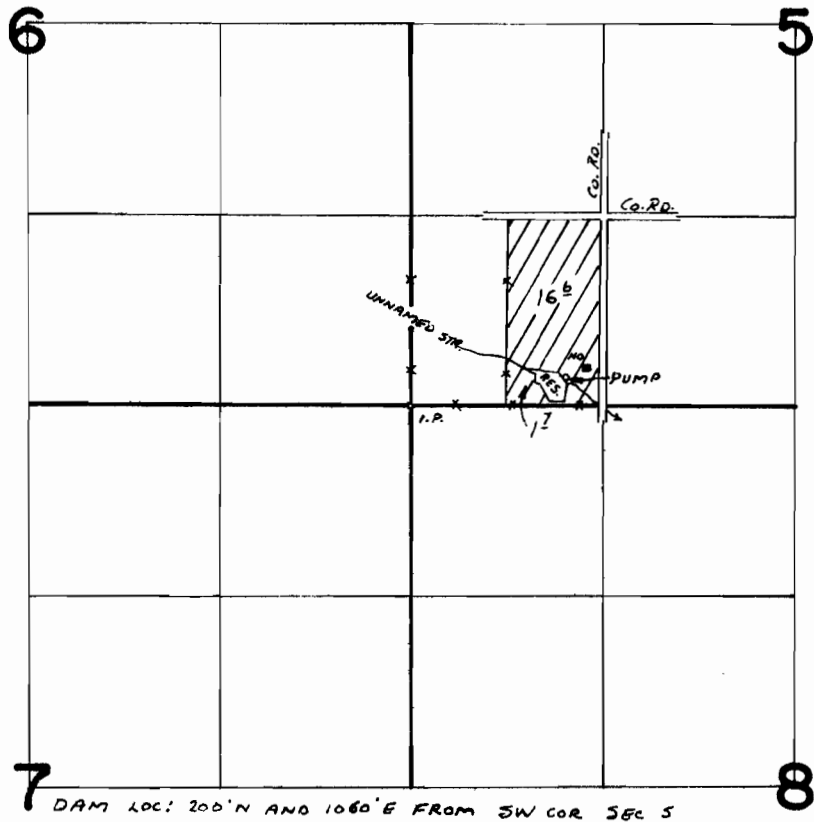

FINAL PROOF SURVEY

UNDER

Application No. **R-42885** 43124 Permit No. **R-4895** 32191

IN NAME OF

LEO DUNTLEY

Surveyed SEPT. 11, 1974, by L. Toll