


T. 36S., R. 5W., W.M.

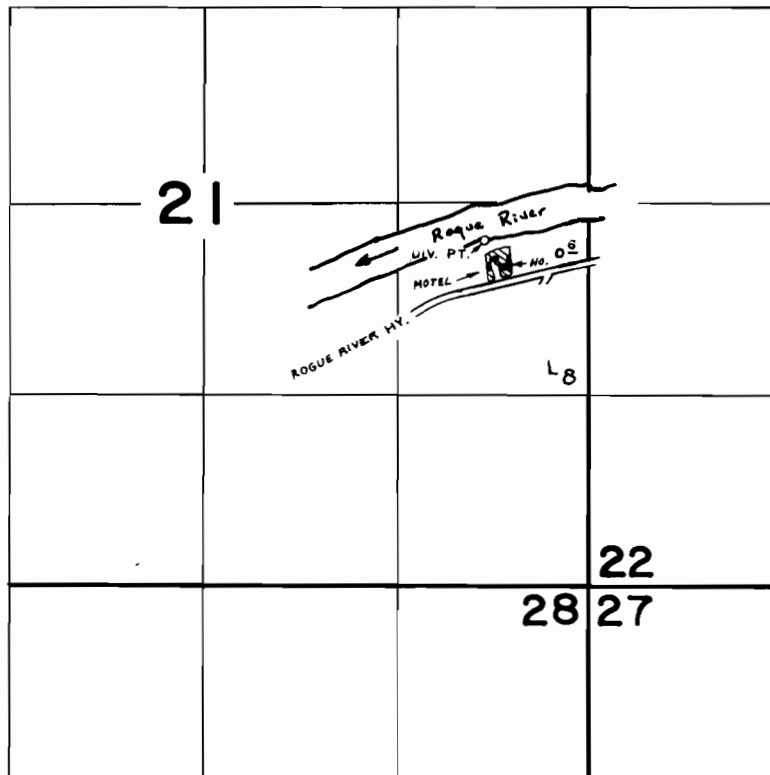

DIV. PT. LOC.: 2380' N. & 4560' E. FROM SW COR. SEC. 21

**FINAL PROOF SURVEY**  
UNDER

Application No. 50232 Permit No. 37907  
IN NAME OF

..... RUSSEL G. NYE .....

Surveyed OCT. 6 1977, by B. SUND .....