


T. 11S. R. 2W. W.M.

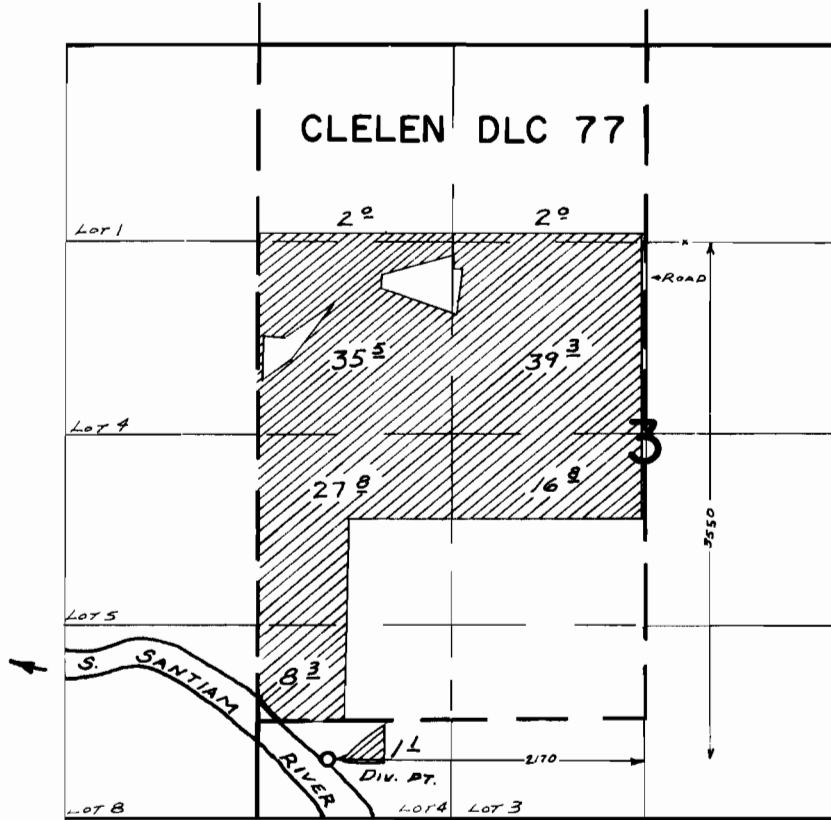

FINAL PROOF SURVEY
UNDER

Application No. 41962 Permit No. 31415
IN NAME OF

SHUMAKER BROS.

Surveyed *MAY 28, 1969*, by *W. RUPPERT*