


T.6S. R.IE., W.M.

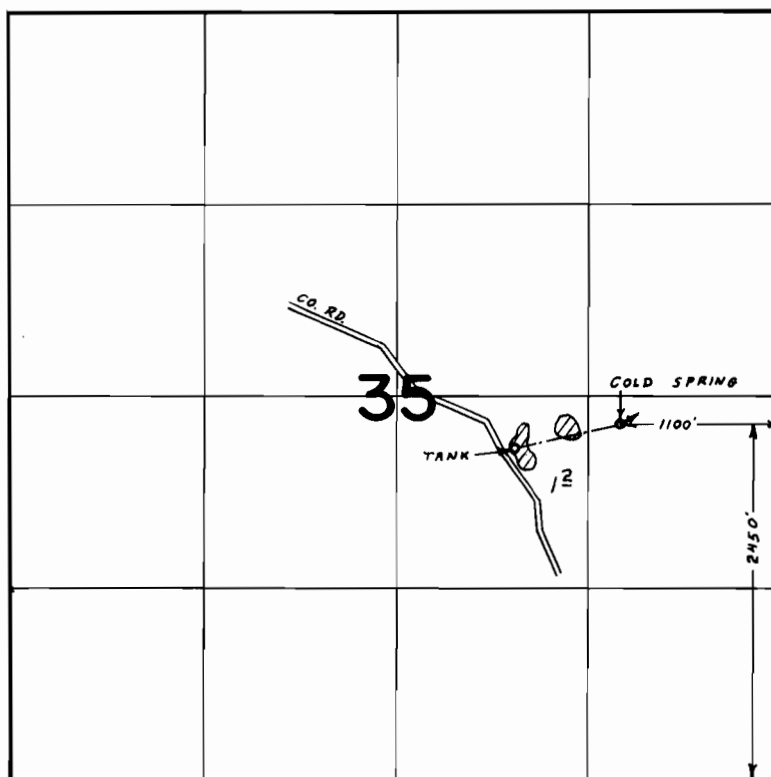

FINAL PROOF SURVEY UNDER

Application No. 52141..... Permit No. 37766.....
IN NAME OF

Russell Thomas Swider

Surveyed JUNE...7... 1979, by L. H. NUNN.....