


# T.6S. R.2W., W.M.

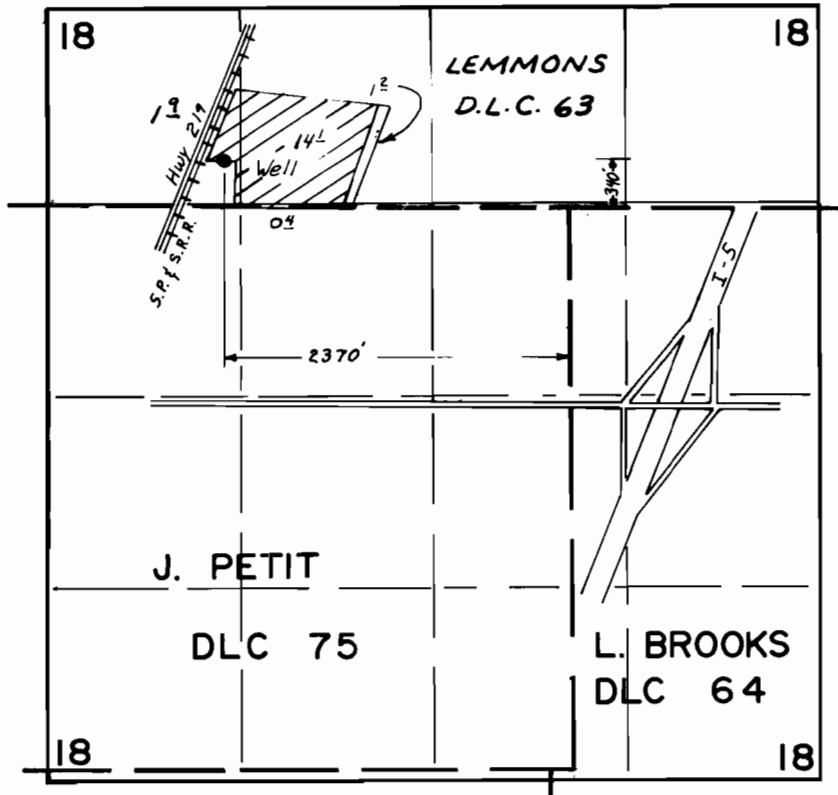

## FINAL PROOF SURVEY UNDER

Application No. G-7160. Permit No. G-6606.  
IN NAME OF

.....MELODY DITTER.....

Surveyed SEPT. 16 1977, by B. R. SUND.....