


T. 15 & 16, R. 26E, W. 10M.

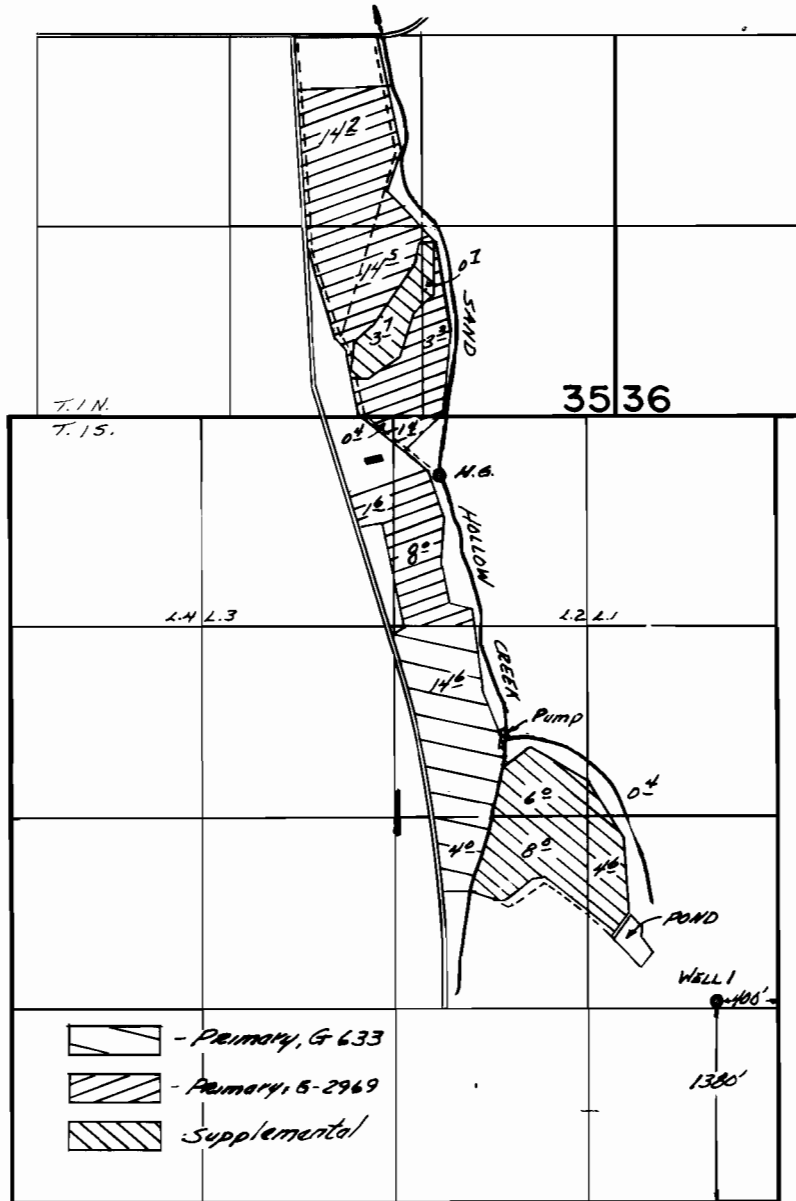

FINAL PROOF SURVEY UNDER

Application No. **G-633** Permit No. **G-2969** **G-541** Permit No. **G-2760**
IN NAME OF

.....**O.W. CUTSFORTH**.....

Surveyed Oct...10... 1961... by **R. JACKSON**.....
June 29 1966, by **L. GOULD**