T. 15 & 1N, R. 26E, W. M.

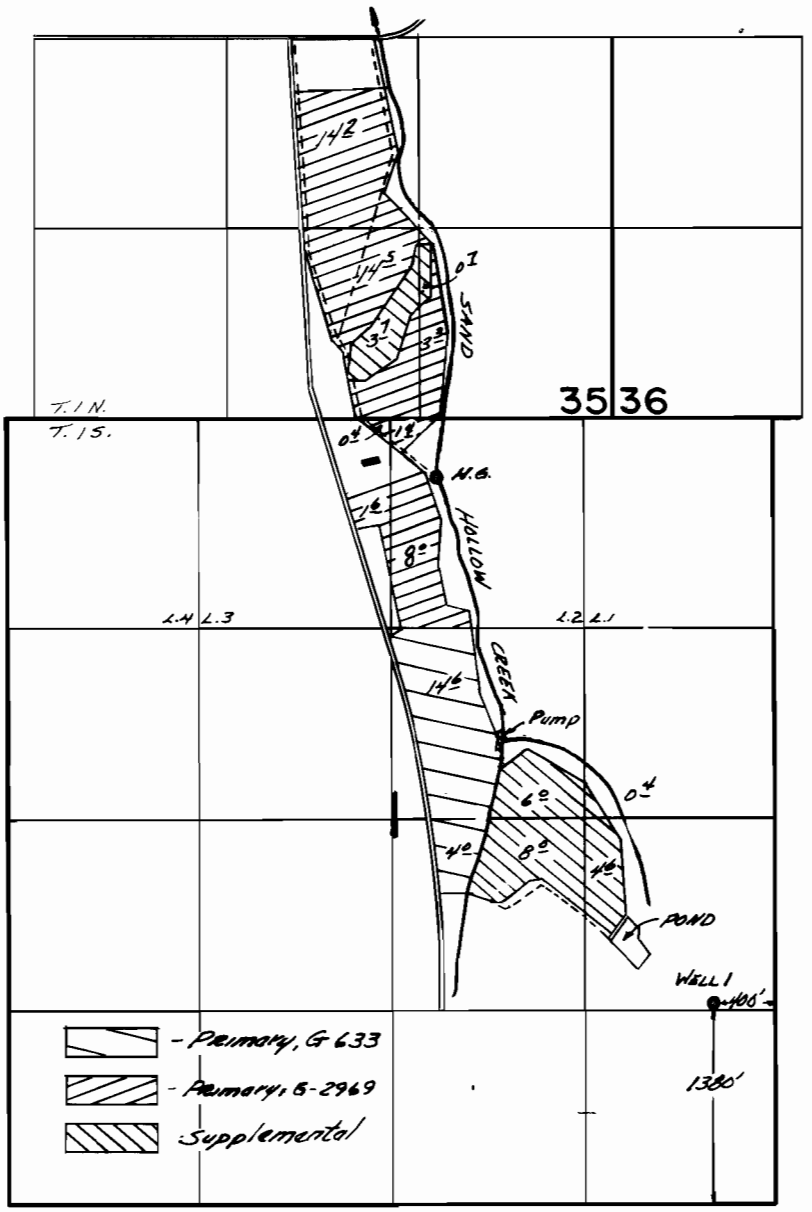

FINAL PROOF SURVEY

UNDER

Application No. G-633 ~~G-2969~~ Permit No. G-541 ~~G-2760~~

IN NAME OF

O.W. CUTSFORTH

Surveyed Oct. 10 1961, by R. JACKSON
June 29 1966, by L. GOULD

372-63 & 105 LRB.